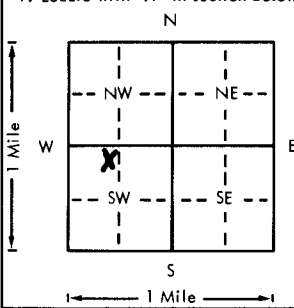
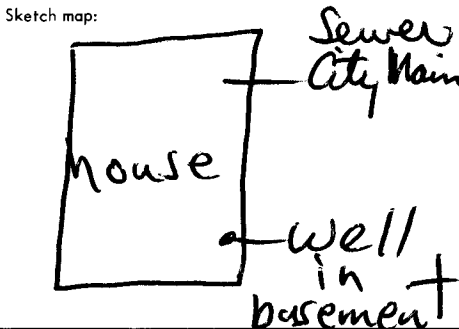


USE TYPEWRITER OR BALL
POINT PEN-PRESS FIRMLY,
PRINT CLEARLY.

WATER WELL RECORD
KSA 820-1201-1215

Kansas Department of Health and
Environment-Division of Environment
(Water well Contractors)
Topeka, Kansas 66620

1. Location of well:		County: <u>Sedgwick</u>	Fraction: <u>NE 1/4 NW 1/4 SW 1/4</u>	Section number: <u>31</u>	Township number: <u>T 27 S</u>	Range number: <u>R 3 E</u>																								
2. Distance and direction from nearest town or city: <u>1/2 W. to Garden Plain Ks.</u>				3. Owner of well: <u>Robt Meyer Const.</u> R.R. or street: <u>R.R.</u> City, state, zip code: <u>Garden Plain Ks 67050</u>																										
4. Locate with "X" in section below:		Sketch map:		6. Bore hole dia. <u>7 1/2</u> in. Completion date <u>7/15/78</u> Well depth <u>76</u> ft.																										
				7. ☐ Cable tool ☒ Rotary ☐ Driven ☐ Dug ☐ Hollow rod ☐ Jetted ☐ Bored ☐ Reverse rotary																										
5. Type and color of material				8. Use: ☒ Domestic ☐ Public supply ☐ Industry ☐ Irrigation ☐ Air conditioning ☐ Stock ☐ Lawn ☐ Oil field water ☐ Other																										
<table border="1"><thead><tr><th></th><th>From</th><th>To</th></tr></thead><tbody><tr><td>Top soil</td><td>0</td><td>3</td></tr><tr><td>fine sand.</td><td>3</td><td>20</td></tr><tr><td>Red clay.</td><td>20</td><td>35</td></tr><tr><td>fine to med. sand.</td><td>35</td><td>43</td></tr><tr><td>red. shale.</td><td>43</td><td>62</td></tr><tr><td>blue-green shale.</td><td>62</td><td>67</td></tr><tr><td>red shale.</td><td>67</td><td>76</td></tr></tbody></table>					From	To	Top soil	0	3	fine sand.	3	20	Red clay.	20	35	fine to med. sand.	35	43	red. shale.	43	62	blue-green shale.	62	67	red shale.	67	76	9. Casing: Material <u>Steel</u> Height (Above or below surface) <u>12</u> in. Threaded ☒ Welded ☐ RMP ☒ PVC Weight <u>1.50</u> lbs./ft. Dia. <u>5</u> in. to <u>7 1/2</u> ft. depth Wall Thickness: inches or Dia. <u>5</u> in. to <u>7 1/2</u> ft. depth gage No. <u>1200</u>		
				10. Screen: Manufacturer's name <u>Sunflower</u> Type <u>200</u> Dia. <u>5 1/4</u> Slot gauge <u>1/16</u> Length <u>30</u> Set between <u>46</u> ft. and <u>76</u> ft. Gravel pack? <u>yes</u> Size range of material <u>3/8</u>																										
				11. Static water level: <u>38</u> ft. below land surface Date <u>7/15/78</u>																										
				12. Pumping level below land surfaces: <u>45</u> ft. after <u>1/2</u> hrs. pumping <u>15</u> g.p.m. <u>45</u> ft. after <u>1/2</u> hrs. pumping <u>15</u> g.p.m. Estimated maximum yield <u>30</u> g.p.m.																										
				13. Water sample submitted: <u>no.</u> /day/yr. ☐ Yes ☒ No Date <u>7/15/78</u>																										
				14. Well head completion: ☐ Pitless adapter <u>12</u> inches above grade																										
				15. Well grouted? <u>yes</u> With: ☐ Neat cement ☐ Bentonite ☒ Concrete Depth: From <u>6</u> ft. to <u>16</u> ft.																										
				16. Nearest source of possible contamination: <u>30</u> ft. Direction <u>NO</u> Type <u>city main</u> Well disinfected upon completion? ☒ Yes ☐ No																										
				17. Pump: ☒ Not installed Manufacturer's name _____ Model number _____ HP _____ Volts _____ Length of drop pipe _____ ft. capacity _____ g.p.m. Type: ☐ Submersible ☐ Turbine ☐ Jet ☐ Reciprocating ☐ Centrifugal ☐ Other																										
18. Elevation:		19. Remarks:		20. Water well contractor's certification: This well was drilled under my jurisdiction and this report is true to the best of my knowledge and belief. <u>Wm. H. Diller</u> 318 Business name <u>Polowich</u> License No. _____ Address _____ Signed <u>J. Benzer</u> 7/15/78 Authorized representative																										

Forward the white, blue and pink copies to the Department of Health and Environment

Form WWC-5