USE TYPEWRITER OR BALL POINT PEN-PRESS FIRMLY, PRINT CLEARLY.

T	R	EW	sec 1/4 1/4 1/4 No.

WATER WELL RECORD
KSA 82a-1201-1215

Kansas State Dept. Of Health
(Water Well Contractors)
Forbes-Bldg. 740
Topeka, Kansas 66620

1 Location of well:	County	Township name	Fraction	Section number	Town number	Range number
	Sedg.	Garden Plain	SW-NE-NE	31	27S	3W.

Distance and direction from nearest town or city:

Street address of well location if in city: 253 MARYS Garden Plain KS.

3 Owner of well: Melvin Kerschen
Address: 253 Marys Garden Plain KS. 67050

Locate with "X" in section below: N / W / E / S — X in NE quarter, 1 Mile

Sketch map:

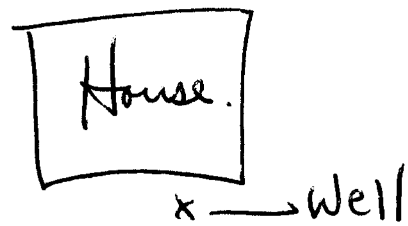

4 Well depth: 75 ft. Date of completion 8/5/76.
Well diameter 5 in. 11"

5 ☐ Cable tool ☒ Rotary ☐ Driven ☐ Dug
☐ Hollow rod ☐ Jetted ☐ Bored ☐ Reverse rotary

6 Use: ☒ Domestic ☐ Public supply ☐ Industry
☐ Irrigation ☐ Air conditioning ☐ Commercial
☐ Test well ☐

7 Casing: Material PVC Height: above/below
Threaded ☐ Welded ☒ Surface 12 in.
Diam 5 in. to 75 ft. depth Weight 231 lbs./ft. 160
Drive shoe? ☐ Yes ☒ No
___ in. to ___ ft. depth

8 Screen:
Manufacturer Pumpco MPI
Type PVC Dia. 5 in.
Slot/gauze 1/16 Length 5 ft.
Set between 70 ft. and 75 ft. 0
Fittings:
Gravel pack ☒ Yes ☐ No Size range of material 3/8

9 Static water level:
30 ft. below land surface Date 8/5/76.

10 Pumping level below land surfaces:
45 ft. after 1/2 hrs. pumping 20 g.p.m.
___ ft. after ___ hrs. pumping ___ g.p.m.
Estimated maximum yield 25 g.p.m.

11 Water sample submitted:
☐ Yes ☒ No Date ___

12 Well head completion:
☐ Pitless adapter 12 inches above grade

13 Well grouted? ☒ Yes ☐ No
☒ Neat cement ☐ Bentonite ☐
Depth: From 3 ft. to 13 ft.

14 Nearest source of possible contamination: None
ft. ___ Direction ___ Type ___
Well disinfected upon completion? ☒ Yes ☐ No

15 Pump: ☒ Not installed
Manufacturer's name ___
Model number ___ HP ___ Volts ___
Length of drop pipe ___ ft. capacity ___ g.m.p.
Type:
☐ Submersible ☐ Turbine
☐ Jet ☐ Reciprocating
☐ Certrifugal ☐ Other

2 Type and color of material	From	To
Top soil.	0	6
clay.	6	13
med. sand.	13	19
red shale.	19	34
blue shale.	34	39
red + blue shale.	39	75.

(use a second sheet if needed)

16 Remarks: elevation
Customer to furnish 4X4X4 slab around well.

Topography:
☐ Hill
☐ Slope
☒ Upland
☐ Valley

17 Water well contractor's certification:
This well was drilled under my jurisdiction and this report is true to the best of my knowledge and belief.
Business name Wennings Drilling License No. 318
Address Colwich
Signed [signature] Authorized representative Date 8/5/76.

27 3W 31 SWNENE

Forward the white, blue and pink copies to the Kansas State Dept. Of Health.

Form WWC-5

677-H