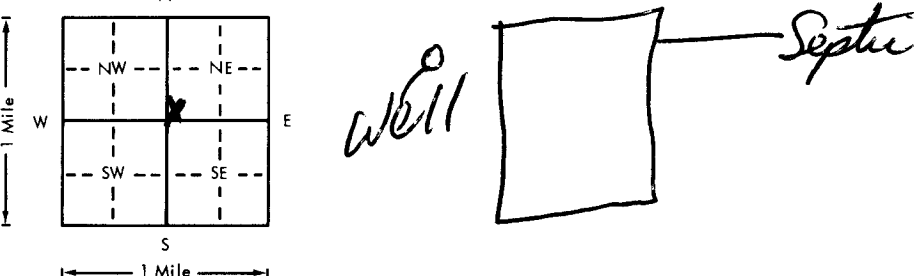


USE TYPEWRITER OR BALL
POINT PEN-PRESS FIRMLY,
PRINT CLEARLY.

RECEIVED MAR 31 1978

WATER WELL RECORD
KSA 826-1201-1215

Kansas Department of Health and
Environment-Division of Environment
(Water well Contractors)
Topeka, Kansas 66620

1. Location of well:		County Sedgewick	Fraction SW 1/4 SW 1/4 NE 1/4	Section number 31	Township number T 27 S	Range number R 3 E
2. Distance and direction from nearest town or city: Street address of well location if in city: 424 Doyle Garden Plain KS				3. Owner of well: Matt Eick, Esq. Esq. 6 R.R. or street: 5512 W. Central City, state, zip code: Winchester KS 67212		
4. Locate with "X" in section below: N W E S 1 Mile Sketch map: 				6. Bore hole dia. 7 1/2 in. Completion date 3/29/78 Well depth 75 ft.		
5. Type and color of material				7. ☒ Cable tool ☒ Rotary ☐ Driven ☐ Dug ☐ Hollow rod ☐ Jetted ☐ Bored ☐ Reverse rotary		
				8. Use: ☒ Domestic ☐ Public supply ☐ Industry ☐ Irrigation ☐ Air conditioning ☐ Stock ☐ Lawn ☐ Oil field water ☐ Other		
				9. Casing: Material Steel Height 0 or below Threaded ☐ Welded ☒ Surface 12 in. RMP ☐ PVC ☐ Weight 1.50 lbs./ft. Dia. 3 in. to 7 1/2 ft. depth Wall Thickness: inches or Dia. ☐ in. to ☐ ft. depth gage No. 200		
				10. Screen: Manufacturer's name Sunflower 200 Dia. 1 1/2 in. Slot gauge 1/16 Length 50 ft. Set between 25 ft. and 75 ft. Gravel pack yes Size range of material 3/8		
				11. Static water level: 18 ft. below land surface Date 3/29/78 12. Pumping level below land surfaces: 30 ft. after 1/2 hrs. pumping 15 g.p.m. 54 ft. after 58 hrs. pumping 35 g.p.m. Estimated maximum yield 35 g.p.m.		
13. Water sample submitted: mo./day/yr. ☐ Yes ☒ No Date				14. Well head completion: ☒ Pitless adapter 12 inches above grade		
15. Well grouted? yes With: ☐ Neat cement ☐ Bentonite ☒ Concrete Depth: From 3 ft. to 13 ft.				16. Nearest source of possible contamination: ft. ☐ Direction None Type ☐ Well disinfected upon completion? ☒ Yes ☐ No		
17. Pump: Manufacturer's name FF W Not installed Model number 10518 HP 1/2 Volts 115 Length of drop pipe 40 ft. capacity 10 g.p.m. Type: ☒ Submersible ☐ Turbine ☐ Jet ☐ Reciprocating ☐ Centrifugal ☐ Other				20. Water well contractor's certification: This well was drilled under my jurisdiction and this report is true to the best of my knowledge and belief. Wenger Drilling 318 Business name License No. Address Sedgewick Signed Wenger Date 3/29/78 Authorized representative		
18. Elevation: Topography: ☐ Hill ☐ Slope ☒ Upland ☐ Valley		19. Remarks: Customer to furnish 4x4x4 slab around casing per State Regulations Signed X Matt Eick				

Forward the white, blue and pink copies to the Department of Health and Environment

Form WWC-5