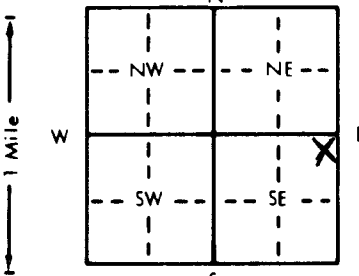


1 LOCATION OF WATER WELL:		Fraction	Section Number	Township Number	Range Number
County: <u>Sedgwick</u>		<u>NE</u> 1/4 <u>NE</u> 1/4 <u>SE</u> 1/4	<u>32</u>	T <u>27</u> S	R <u>3</u> E/W
Distance and direction from nearest town or city street address of well if located within city? <u>15. Garden Plain</u>					
2 WATER WELL OWNER: <u>Rosemary Kirby</u>		Board of Agriculture, Division of Water Resources			
RR#, St. Address, Box #: <u>RT. 1</u>		Application Number:			
City, State, ZIP Code: <u>Garden Plain, KS 67050</u>					
3 LOCATE WELL'S LOCATION WITH AN "X" IN SECTION BOX:		4 DEPTH OF COMPLETED WELL: <u>110</u> ft. ELEVATION: <u>110</u> ft.			
		Depth(s) Groundwater Encountered 1. <u>20</u> ft. 2. <u>50</u> ft. 3. <u>80</u> ft.			
		WELL'S STATIC WATER LEVEL <u>13</u> ft. below land surface measured on mo/day/yr <u>9-18-94</u>			
		Pump test data: Well water was _____ ft. after _____ hours pumping _____ gpm			
		Est. Yield _____ gpm: Well water was _____ ft. after _____ hours pumping _____ gpm			
		Bore Hole Diameter <u>5</u> in. to <u>110</u> ft. and _____ in. to _____ ft.			
		WELL WATER TO BE USED AS: 5 Public water supply 8 Air conditioning 11 Injection well			
		1 Domestic 3 Feedlot 6 Oil field water supply 9 Dewatering 12 Other (Specify below)			
		2 Irrigation 4 Industrial 7 <u>Lawn and garden only</u> 10 Monitoring well			
		Was a chemical/bacteriological sample submitted to Department? Yes _____ No <u>X</u> If yes, mo/day/yr sample was submitted _____			
		Water Well Disinfected? Yes <u>X</u> No _____			
5 TYPE OF BLANK CASING USED:		CASING JOINTS: <u>Glued</u> _____ Clamped _____			
1 Steel 3 RMP (SR)		Welded _____			
2 <u>PVC</u> 4 ABS		Threaded _____			
5 Wrought iron 8 Concrete tile					
6 Asbestos-Cement 9 Other (specify below)					
7 Fiberglass					
Blank casing diameter <u>5</u> in. to <u>70</u> ft. Dia _____ in. to _____ ft. Dia _____ in. to _____ ft.					
Casing height above land surface <u>18</u> in. weight _____ lbs./ft. Wall thickness or gauge No. <u>SDR26</u>					
TYPE OF SCREEN OR PERFORATION MATERIAL:		7 <u>PVC</u> 10 Asbestos-cement			
1 Steel 3 Stainless steel 5 Fiberglass 8 RMP (SR) 11 Other (specify) _____					
2 Brass 4 Galvanized steel 6 Concrete tile 9 ABS 12 None used (open hole)					
SCREEN OR PERFORATION OPENINGS ARE:		8 <u>Saw cut</u> 11 None (open hole)			
1 Continuous slot 3 Mill slot 6 Wire wrapped 9 Drilled holes					
2 Louvered shutter 4 Key punched 7 Torch cut 10 Other (specify) _____					
SCREEN-PERFORATED INTERVALS: From <u>70</u> ft. to <u>110</u> ft. From _____ ft. to _____ ft.					
GRAVEL PACK INTERVALS: From <u>20</u> ft. to <u>110</u> ft. From _____ ft. to _____ ft.					
6 GROUT MATERIAL: 1 Neat cement 2 Cement grout 3 Bentonite 4 Other <u>Baroid-Hole Plug</u>					
Grout Intervals: From <u>0</u> ft. to <u>20</u> ft. From _____ ft. to _____ ft. From _____ ft. to _____ ft.					
What is the nearest source of possible contamination:		10 <u>Livestock pens</u> 14 Abandoned water well			
1 Septic tank 4 Lateral lines 7 Pit privy 11 Fuel storage 15 Oil well/Gas well					
2 Sewer lines 5 Cess pool 8 Sewage lagoon 12 Fertilizer storage 16 Other (specify below)					
3 Watertight sewer lines 6 Seepage pit 9 Feedyard 13 Insecticide storage					
Direction from well? <u>W</u>		How many feet? <u>50</u>			
FROM	TO	LITHOLOGIC LOG	FROM	TO	PLUGGING INTERVALS
0	2	Soil			
2	15	Clay			
15	19	Fine Sand			
19	110	Blue Shale			
7 CONTRACTOR'S OR LANDOWNER'S CERTIFICATION: This water well was (1) <u>constructed</u> , (2) reconstructed, or (3) plugged under my jurisdiction and was completed on (mo/day/year) <u>9-18-94</u> and this record is true to the best of my knowledge and belief. Kansas Water Well Contractor's License No. <u>395</u> This Water Well Record was completed on (mo/day/yr) <u>10-26-94</u> under the business name of <u>Craig Roberts Co.</u> by (signature) <u>Craig Roberts</u>					
INSTRUCTIONS: Use typewriter or ball point pen. PLEASE PRESS FIRMLY and PRINT clearly. Please fill in blanks, underline or circle the correct answers. Send top three copies to Kansas Department of Health and Environment, Bureau of Water, Topeka, Kansas 66620-0001. Telephone: 913-296-5545. Send one to WATER WELL OWNER and retain one for your records.					

OFFICE USE ONLY

T

R

EW

SEC.

1/4

1/4

1/4