

## WATER WELL RECORD Form WWC-5 KSA 82a-1212

1 LOCATION OF WATER WELL:	Fraction County: <b>Gray</b>	1/4 <b>NE 1/4 SE 1/4</b>	Section Number 2	Township Number T 27 S	Range Number R 30 E
---------------------------	---------------------------------	--------------------------	---------------------	---------------------------	------------------------

Distance and direction from nearest town or city street address of well if located within city?

**City of Chanlerston + 50 - 9 3/4 miles South + 1/4 East**2 WATER WELL OWNER: **RAY Allen Smith.**

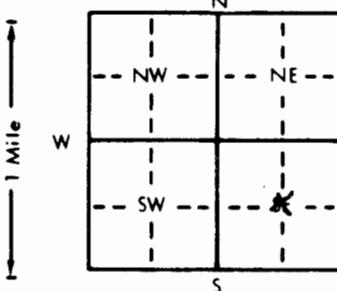
RR#, St. Address, Box # :

City, State, ZIP Code : **05505 S. Rd Ingalls, KS. 67853**

Board of Agriculture, Division of Water Resources

Application Number: **27260**

3 LOCATE WELL'S LOCATION WITH AN "X" IN SECTION BOX:

4 DEPTH OF COMPLETED WELL. **197'** ft. ELEVATION: .....

Depth(s) Groundwater Encountered 1. .... ft. 2. .... ft. 3. .... ft.

WELL'S STATIC WATER LEVEL **142** ft. below land surface measured on mo/day/yr **4-15-97**

Pump test data: Well water was ..... ft. after ..... hours pumping ..... gpm

Est. Yield ..... gpm: Well water was ..... ft. after ..... hours pumping ..... gpm

Bore Hole Diameter ..... in. to ..... ft., and ..... in. to ..... ft.

WELL WATER TO BE USED AS: 5 Public water supply 8 Air conditioning 11 Injection well

1 Domestic 3 Feedlot 6 Oil field water supply 9 Dewatering 12 Other (Specify below)

2 Irrigation 4 Industrial 7 Lawn and garden only 10 Monitoring well

Was a chemical/bacteriological sample submitted to Department? Yes ..... No ..... If yes, mo/day/yr sample was submitted

Water Well Disinfected? Yes ..... No

5 TYPE OF BLANK CASING USED:

- 1 Steel
- 3 RMP (SR)
- 2 PVC
- 4 ABS

5 Wrought iron

6 Asbestos-Cement

7 Fiberglass

8 Concrete tile

9 Other (specify below)

CASING JOINTS: Glued ..... Clamped .....

Welded .....

Threaded .....

Blank casing diameter ..... in. to ..... ft., Dia ..... in. to ..... ft., Dia ..... in. to ..... ft.

Casing height above land surface ..... in., weight ..... lbs./ft. Wall thickness or gauge No. ....

TYPE OF SCREEN OR PERFORATION MATERIAL:

- 1 Steel
- 3 Stainless steel
- 5 Fiberglass
- 7 PVC
- 10 Asbestos-cement
- 2 Brass
- 4 Galvanized steel
- 6 Concrete tile
- 9 ABS
- 11 Other (specify) .....
- 12 None used (open hole)

SCREEN OR PERFORATION OPENINGS ARE:

- 1 Continuous slot
- 3 Mill slot
- 5 Gauzed wrapped
- 8 Saw cut
- 11 None (open hole)
- 2 Louvered shutter
- 4 Key punched
- 6 Wire wrapped
- 9 Drilled holes
- 10 Other (specify) **UnKnown**

SCREEN-PERFORATED INTERVALS: From **UnKnown** ft. to ..... ft., From ..... ft. to ..... ft.

From ..... ft. to ..... ft., From ..... ft. to ..... ft.

GRAVEL PACK INTERVALS: From **UnKnown** ft. to ..... ft., From ..... ft. to ..... ft.

From ..... ft. to ..... ft., From ..... ft. to ..... ft.

6 GROUT MATERIAL: 1 Neat cement 2 Cement grout 3 Bentonite 4 Other .....

Grout Intervals: From ..... ft. to ..... ft., From ..... ft. to ..... ft., From ..... ft. to ..... ft.

What is the nearest source of possible contamination:

- 1 Septic tank
- 4 Lateral lines
- 7 Pit privy
- 10 Livestock pens
- 14 Abandoned water well
- 2 Sewer lines
- 5 Cess pool
- 8 Sewage lagoon
- 11 Fuel storage
- 15 Oil well/Gas well
- 3 Watertight sewer lines
- 6 Seepage pit
- 9 Feedyard
- 12 Fertilizer storage
- 16 Other (specify below)
- 9 Feedyard
- 13 Insecticide storage

Direction from well? **House well 3 1/4 mile north** How many feet? **3 1/4 mile**

FROM TO LITHOLOGIC LOG FROM TO PLUGGING INTERVALS

**197 140 Chlorinated Gravel fill**  
**140 136 Hole plug.**  
**136 14' Sandy clay fill.**  
**14 4' Cement,**

7 CONTRACTOR'S OR LANDOWNER'S CERTIFICATION: This water well was (1) constructed, (2) reconstructed, or (3) plugged under my jurisdiction and was completed on (mo/day/year) ..... and this record is true to the best of my knowledge and belief. Kansas

Water Well Contractor's License No. ..... This Water Well Record was completed on (mo/day/yr) **4-16-97** ..... by (signature) **Ray Allen Smith**