

WATER WELL RECORD Form WWC-5 KSA 82a-1212


1 LOCATION OF WATER WELL:	Fraction SW 1/4 SW 1/4 SW 1/4	Section Number 20	Township Number T 27 S	Range Number R 30 E
---------------------------	----------------------------------	----------------------	---------------------------	------------------------

Distance and direction from nearest town or city street address of well if located within city?

9 1/2 Miles North of Copeland

2 WATER WELL OWNER:	Eugene Unruh	Board of Agriculture, Division of Water Resources
RR#, St. Address, Box #	02304 W Road	Application Number:
City, State, ZIP Code	Copeland, Ks. 67837	

3 LOCATE WELL'S LOCATION WITH AN "X" IN SECTION BOX:	4 DEPTH OF RECORDED WELL. 205 ft. ELEVATION:
------------------------------------------------------	---------------------------------------------------------------------------

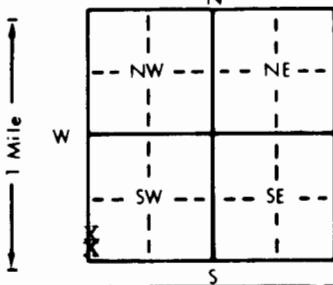

Depth(s) Groundwater Encountered 1. ft. 2. ft. 3. ft.
WELL'S STATIC WATER LEVEL 170 ft. below land surface measured on mo/day/yr 5-6-97
Pump test data: Well water was ft. after hours pumping gpm
Est. Yield gpm: Well water was ft. after hours pumping gpm
Bore Hole Diameter in. to ft., and in. to ft.
WELL WATER TO BE USED AS: 5 Public water supply 8 Air conditioning 11 Injection well
1 Domestic 3 Feedlot 6 Oil field water supply 9 Dewatering 12 Other (Specify below)
WAS Irrigation 4 Industrial 7 Lawn and garden only 10 Monitoring well
Was a chemical/bacteriological sample submitted to Department? Yes No If yes, mo/day/yr sample was submitted
Water Well Disinfected? Yes <input checked="" type="checkbox"/> No <input type="checkbox"/>

5 TYPE OF BLANK CASING USED:	5 Wrought iron 8 Concrete tile CASING JOINTS: Glued Clamped
1 Steel 3 RMP (SR) 6 Asbestos-Cement 9 Other (specify below) Welded	
2 PVC 4 ABS 7 Fiberglass Threaded	

Blank casing diameter in. to 205 ft., Dia in. to ft., Dia in. to ft.

Casing height above land surface in., weight lbs./ft. Wall thickness or gauge No.

TYPE OF SCREEN OR PERFORATION MATERIAL:	7 PVC 10 Asbestos-cement
1 Steel 3 Stainless steel 5 Fiberglass 8 RMP (SR) 11 Other (specify)	
2 Brass 4 Galvanized steel 6 Concrete tile 9 ABS 12 None used (open hole)	

SCREEN OR PERFORATION OPENINGS ARE:	5 Gauzed wrapped 8 Saw cut 11 None (open hole)
1 Continuous slot 3 Mill slot 6 Wire wrapped 9 Drilled holes	
2 Louvered shutter 4 Key punched 7 Torch cut 10 Other (specify)	

SCREEN-PERFORATED INTERVALS: From ft. to ft., From ft. to ft.

From ft. to ft., From ft. to ft.

GRAVEL PACK INTERVALS: From ft. to ft., From ft. to ft.

From ft. to ft., From ft. to ft.

6 GROUT MATERIAL:	1 Neat cement 2 Cement grout 3 Bentonite 4 Other
Grout Intervals: From 6 ft. to 12 ft., From ft. to ft., From ft. to ft.	

What is the nearest source of possible contamination:

1 Septic tank 4 Lateral lines 7 Pit privy 10 Livestock pens 14 Abandoned water well
2 Sewer lines 5 Cess pool 8 Sewage lagoon 11 Fuel storage 15 Oil well/Gas well
3 Watertight sewer lines 6 Seepage pit 9 Feedyard 12 Fertilizer storage 16 Other (specify below)
13 Insecticide storage

Direction from well?

FROM TO LITHOLOGIC LOG FROM TO PLUGGING INTERVALS

205 100 Sand

100 12 Clay

12 6 Cement

6 0 Clay

by farmer

7 CONTRACTOR'S OR LANDOWNER'S CERTIFICATION: This water well was (1) constructed, (2) reconstructed, or (3) plugged under my jurisdiction and was completed on (mo/day/year) 5-30-97 and this record is true to the best of my knowledge and belief. Kansas

Water Well Contractor's License No. 223 This Water Well Record was completed on (mo/day/yr) 6-3-97

under the business name of Dunham Drilling Company by (signature) Karen Dunham