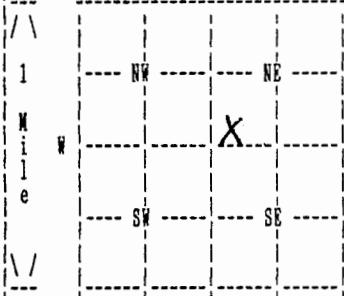


## WATER WELL RECORD Form WWC-5 KSA 82a-1212

|                           |                          |                      |                      |                           |                        |
|---------------------------|--------------------------|----------------------|----------------------|---------------------------|------------------------|
| 1 LOCATION OF WATER WELL: | Fraction<br>COUNTY: GRAY | SW 1/4 SW 1/4 NE 1/4 | Section Number<br>10 | Township Number<br>T 27 S | Range Number<br>R 30 W |
|---------------------------|--------------------------|----------------------|----------------------|---------------------------|------------------------|

Distance and direction from nearest town or city street address of well if located within city?  
FROM COPELAND, KS. - 12 MILES NORTH AND 3 MILES EAST

2 WATER WELL OWNER: SCHMIDT, WALLACE  
RR#, St. Address, Box #: 201 S. RY  
City, State, ZIP code : MONTEZUMA, KS 67867-  
Board of Agriculture, Division of Water Resources  
Application Number:

|  |   |
|--|---|
| 3 LOCATE WELL'S LOCATION WITH<br>AN "X" IN SECTION BOX:                          | 4 DEPTH OF COMPLETED WELL 140 ELEVATION: 0<br>Depth(s) Groundwater Encountered 1. 0 ft. 2. 0 ft. 3. 0 ft.   |
|  | WELL'S STATIC WATER LEVEL 0 ft. below land surface measured on mo/day/yr<br>Pump testdata: Well water was 0 ft. after 0 hours pumping 0 gpm<br>Estimated Yield 0 gpm: Well water was 0 ft. after 0 hours pumping 0 gpm<br>Bore Hole Diameter in. to 0 ft., and in. to 0 ft.<br>WELL WATER WAS: DOMESTIC Irrigation<br>Was a chemical/bacteriological sample submitted to department? No ;<br>If yes, mo/day/yr sample was submitted Water well disinfected? Yes |

5 TYPE OF BLANK CASING USED: STEEL CASING JOINTS:  
 Blank casing diameter 16 in. to 140 ft., Dia in. to 0 ft., Dia in. to 0 ft.  
 Casing height above land surface 0 in., weight 0 lbs/ft. Wall thickness or gauge No.

TYPE OF SCREEN OR PERFORATION MATERIAL:  
SCREEN OR PERFORATION OPENINGS ARE:

|                              |  |
|------------------------------|--|
| SCREEN PERFORATED INTERVALS: | From 0 ft. to 0 ft., From 0 ft. to 0 ft. |
|                              | From 0 ft. to 0 ft., From 0 ft. to 0 ft. |
| GRAVEL PACK INTERVALS:       | From 0 ft. to 0 ft., From 0 ft. to 0 ft. |
|                              | From 0 ft. to 0 ft., From 0 ft. to 0 ft. |

6 GROUT MATERIAL BENTONITE  
 Grout Intervals: From 0 ft. to 0 ft., From 0 ft. to 0 ft., From 0 ft. to 0 ft.  
 What is the nearest source of possible contamination: NONE  
 Direction from well?

How many feet? 0

| FROM | TO | LITHOLOGIC LOG | FROM | TO  | PLUGGING INTERVALS |
|------|----|----------------|------|-----|--------------------|
|      |    |                | 0    | 9   | CLAY               |
|      |    |                | 9    | 11  | CEMENT             |
|      |    |                | 11   | 14  | BENTONITE GROUT    |
|      |    |                | 14   | 35  | CLAY               |
|      |    |                | 35   | 140 | FILL SAND          |
|      |    |                | 0    | 0   |                    |
|      |    |                | 0    | 0   |                    |
7 CONTRACTOR'S OR LANDOWNER'S CERTIFICATION: This water well was Plugged under my jurisdiction and was completed on (mo/day/year) 06/22/93 and this record is true to the best of my knowledge and belief. Kansas Water Well Contractor's License No. 179 This Water Well Record was completed on (mo/day/yr) 06/30/93 under the business name of JOE'S WELL SERVICE, INC. by (signature) *Judith Clark*