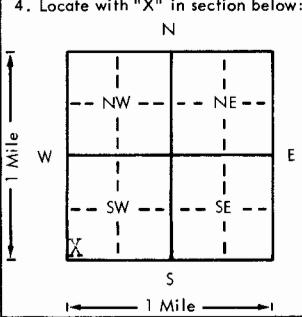


USE TYPEWRITER OR BALL  
POINT PEN-PRESS FIRMLY,  
PRINT CLEARLY.

WATER WELL RECORD  
KSA 82a-1201-1215

Kansas Department of Health and  
Environment-Division of Environment  
(Water well Contractors)  
Topeka, Kansas 66620

1. Location of well:	County Gray	Fraction SW 1/4 SW 1/4 SW 1/4	Section number 17	Township number T 27	Range number S R 30	EW
2. Distance and direction from nearest town or city: 10 1/2 miles north of Copeland, Kansas	3. Owner of well: Paul Loucks R.R. or street: Route 1 City, state, zip code: Copeland, Kansas 67837					
4. Locate with "X" in section below:  	Sketch map:					
5. Type and color of material Top soil and clay	From 0	To 15	6. Bore Hole dia. 28 in. Completion date 6-4-79 Well depth 220 ft.			
Fine sand and clay	15	60	7. Cable tool <input type="checkbox"/> Rotary <input type="checkbox"/> Driven <input type="checkbox"/> Dug <input type="checkbox"/> Hollow rod <input type="checkbox"/> Jetted <input type="checkbox"/> Bored <input checked="" type="checkbox"/> Reverse rotary			
Sand & little clay	60	90	8. Use: <input type="checkbox"/> Domestic <input type="checkbox"/> Public supply <input type="checkbox"/> Industry <input checked="" type="checkbox"/> Irrigation <input type="checkbox"/> Air conditioning <input type="checkbox"/> Stock <input type="checkbox"/> Lawn <input type="checkbox"/> Oil field water <input type="checkbox"/> Other			
sand, coarse and little clay	90	105	9. Casing: Material <input checked="" type="checkbox"/> steel Height: Above or below Threaded <input type="checkbox"/> Welded <input checked="" type="checkbox"/> Surface 12 in. RMP <input type="checkbox"/> PVC <input type="checkbox"/> Weight lbs./ft. Dia. 12 in. to 220 ft. depth Wall Thickness: inches or Dia. <input type="checkbox"/> in. to <input type="checkbox"/> ft. depth gage No. 8 ga.			
sand, coarse and 1' of clay	105	120	10. Screen: Manufacturer's name W. A. Brown Ent.			
sand, coarse, 3' cemented sand & little clay	120	132	Type <input type="checkbox"/> Bridge <input type="checkbox"/> Dia. 16" Slot/gauze <input type="checkbox"/> S107 <input type="checkbox"/> Length 2 1/2" Set between <input type="checkbox"/> 140 ft. and <input type="checkbox"/> 220 ft. ft. and <input type="checkbox"/> ft.			
clay and little cemented sand	132	135	Gravel pack? <input checked="" type="checkbox"/> Size range of material 5/8			
clay and little cemented sand (hard)	135	141	11. Static water level: mo./day/yr. 115 ft. below land surface Date 6-4-79			
Sand	141	145	12. Pumping level below land surfaces: ft. after <input type="checkbox"/> hrs. pumping <input type="checkbox"/> g.p.m. ft. after <input type="checkbox"/> hrs. pumping <input type="checkbox"/> g.p.m. Estimated maximum yield <input type="checkbox"/> g.p.m.			
Cemented sand (hard)	145	147	13. Water sample submitted: mo./day/yr. Yes <input checked="" type="checkbox"/> No <input type="checkbox"/> Date			
Sand	147	155	14. Well head completion: 12" Inches above grade Pitless adapter <input type="checkbox"/>			
Clay	155	162	15. Well grouted? <input checked="" type="checkbox"/> Yes With: <input checked="" type="checkbox"/> Neat cement <input type="checkbox"/> Bentonite <input type="checkbox"/> Concrete Depth: From <input type="checkbox"/> 0 ft. to <input type="checkbox"/> 10 ft.			
Sand	162	172	16. Nearest source of possible contamination: None ft. <input type="checkbox"/> Direction <input type="checkbox"/> Type			
Clay	172	186	Well disinfected upon completion? <input checked="" type="checkbox"/> Yes <input type="checkbox"/> No			
Sand	186	194	17. Pump: <input type="checkbox"/> Not installed Manufacturer's name <input type="checkbox"/> Johnson Model number <input type="checkbox"/> HP <input type="checkbox"/> Volts			
Clay	194	197	Length of drop pipe <input type="checkbox"/> 200 ft. capacity <input type="checkbox"/> g.p.m. Type: <input type="checkbox"/> Submersible <input checked="" type="checkbox"/> Turbine <input type="checkbox"/> Jet <input type="checkbox"/> Reciprocating <input type="checkbox"/> Centrifugal <input type="checkbox"/> Other			
Sand	197	208	18. Elevation:	19. Remarks: Machine Leveled		
Clay	208	210	20. Water well contractor's certification: This well was drilled under my jurisdiction and this report is true to the best of my knowledge and belief.			
Clay and little lime	210	240	Dunham Drilling Company 223 Business name <input type="checkbox"/> Address Copeland, Kansas 67837 Signed <input type="checkbox"/> Date 6-23-79 Authorized representative			
Clay and little lime (hard)	240	251				
Fine sand	251	253				
Clay and little lime	253	255				

Forward the white, blue and pink copies to the Department of Health and Environment

Form WWC-5