

## WATER WELL RECORD

Form WWC-5

KSA 82a-1212

1 LOCATION OF WATER WELL:		Fraction SE $\frac{1}{4}$ SE $\frac{1}{4}$ SW $\frac{1}{4}$	Section Number 17	Township Number T 27 S	Range Number R 30 E/W
---------------------------	--	--	----------------------	---------------------------	--------------------------

Distance and direction from nearest town or city street address of well if located within city?

10 Mile North &amp; 1 Mile East of Copeland

2 WATER WELL OWNER: Mr. Eugene Unruh

RR#, St. Address, Box #: Route 1 Box 22B

Board of Agriculture, Division of Water Resources

City, State, ZIP Code: Copeland, Kansas 67837

Application Number: 8990

3 LOCATE WELL'S LOCATION WITH AN "X" IN SECTION BOX:		4 DEPTH OF COMPLETED WELL ..... 297 ft. ELEVATION: ..... 278 ft. 285 ft.
--	--	--


Depth(s) Groundwater Encountered 1. 180 ft. 2. 278 ft. 3. 285 ft.

WELL'S STATIC WATER LEVEL ..... 145 ft. below land surface measured on mo/day/yr ..... 3-3-1994

Pump test data: Well water was 180 ft. after 4 hours pumping 500 gpm

Est. Yield 1000 gpm: Well water was 200 ft. after 2 hours pumping 1000 gpm

Bore Hole Diameter 26 in. to 297 ft. and in. to ft.

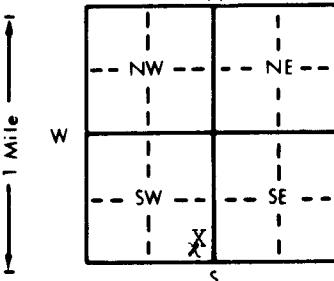

WELL WATER TO BE USED AS: 5 Public water supply 8 Air conditioning 11 Injection well

1 Domestic 3 Feedlot 6 Oil field water supply 9 Dewatering 12 Other (Specify below)

2 Irrigation 4 Industrial 7 Lawn and garden only 10 Monitoring well

Was a chemical/bacteriological sample submitted to Department? Yes X; If yes, mo/day/yr sample was submitted

Water Well Disinfected? Yes X No

5 TYPE OF BLANK CASING USED:		5 Wrought iron 8 Concrete tile CASING JOINTS: Glued X Clamped
------------------------------	--	---

1 Steel 3 RMP (SR) 6 Asbestos-Cement 9 Other (specify below) Welded

2 PVC 4 ABS 7 Fiberglass Threaded

Blank casing diameter 16 in. to 257 ft., Dia. in. to ft., Dia. in. to ft.

Casing height above land surface 12" in., weight lbs./ft. Wall thickness or gauge No. CL160 .616

TYPE OF SCREEN OR PERFORATION MATERIAL:		7 PVC 10 Asbestos-cement
---	--	--------------------------

1 Steel 3 Stainless steel 5 Fiberglass 8 RMP (SR) 11 Other (specify)

2 Brass 4 Galvanized steel 6 Concrete tile 9 ABS 12 None used (open hole)

SCREEN OR PERFORATION OPENINGS ARE:		5 Gauzed wrapped 8 Saw cut 11 None (open hole)
-------------------------------------	--	--

1 Continuous slot 3 Mill slot 6 Wire wrapped 9 Drilled holes

2 Louvered shutter 4 Key punched 7 Torch cut 10 Other (specify)

SCREEN-PERFORATED INTERVALS: From ..... 257 ft. to ..... 297 ft., From ..... ft. to ..... ft.	
---	--

From ..... ft. to ..... ft., From ..... ft. to ..... ft.

GRAVEL PACK INTERVALS: From ..... 20 ft. to ..... 297' ft., From ..... ft. to ..... ft.	
---	--

From ..... ft. to ..... ft., From ..... ft. to ..... ft.

6 GROUT MATERIAL: 1 Neat cement 2 Cement grout 3 Bentonite 4 Other	
--	--

Grout Intervals: From ..... 0 ft. to ..... 20 ft., From ..... ft. to ..... ft., From ..... ft. to ..... ft.

What is the nearest source of possible contamination:

1 Septic tank 4 Lateral lines 7 Pit privy 10 Livestock pens 14 Abandoned water well

2 Sewer lines 5 Cess pool 8 Sewage lagoon 11 Fuel storage 15 Oil well/Gas well

3 Watertight sewer lines 6 Seepage pit 9 Feedyard 12 Fertilizer storage 16 Other (specify below)

Direction from well? East (Will be plugged)

How many feet? 300

FROM			TO			LITHOLOGIC LOG			FROM			TO			PLUGGING INTERVALS		
0	15	Topsoil & clay	195	218	Clay & little lime												
15	45	Clay & Fine Sand	218	225	Fine sand & clay												
45	60	Fine Sand & clay	225	233	Clay & little lime & little fine sand												
60	75	Sand & Gravel & little clay	233	241	Sand (little fine)												
75	82	Clay & little lime	241	270	Clay & little lime												
82	135	Sand & gravel	270	277	Clay (Gum)												
135	141	XXXX Clay & little lime	277	283	Sand												
141	143	Sand	283	285	Clay & little lime												
143	150	Clay & little sand	285	291	Sand (dourse) & little cemented sand												
150	165	Clay & little lime	291	298	Clay & little lime												
165	166	Clay	298	300	Shale												
166	180	Sand & 2' clay															
180	182	Sand															
182	186	Clay															
186	195	Sand															

7 CONTRACTOR'S OR LANDOWNER'S CERTIFICATION: This water well was (1) constructed, (2) reconstructed, or (3) plugged under my jurisdiction and was completed on (mo/day/year) 3-7-94 and this record is true to the best of my knowledge and belief. Kansas

Water Well Contractor's License No. 223 This Water Well Record was completed on (mo/day/yr) 3-18-94

under the business name of Dunham Drilling Company by (signature) Karen Dunham

INSTRUCTIONS: Use typewriter or ball point pen. PLEASE PRESS FIRMLY and PRINT clearly. Please fill in blanks, underline or circle the correct answers. Send top three copies to Kansas Department of Health and Environment, Bureau of Water, Topeka, Kansas 66620-0001. Telephone: 913-296-5545. Send one to WATER WELL OWNER and retain one for your records.

00028

OFFICE USE ONLY