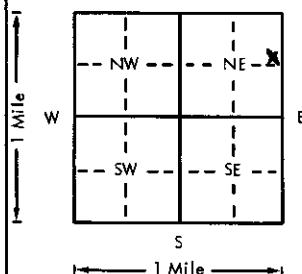


USE TYPEWRITER OR BALL  
POINT PEN-PRESS FIRMLY,  
PRINT CLEARLY.

WATER WELL RECORD  
KSA 82a-1201-1215

Kansas Department of Health and  
Environment-Division of Environment  
(Water well Contractors)  
Topeka, Kansas 66620

1. Location of well:	County <b>Gray</b>	Fraction <b>SE 1/4</b>	NE 1/4	NE 1/4	Section number <b>31</b>	T 27	S 30	E/W
2. Distance and direction from nearest town or city: Street address of well location if in city:	<b>8 1/2 Mi. North of Copeland, KS.</b>				3. Owner of well: R.R. or street: City, state, zip code:	<b>Ferris Hornbaker</b> <b>Copeland, Ks. 67837</b>		
4. Locate with "X" in section below:	Sketch map: 				6. Bore hole dia. <b>9</b> in. Completion date <b>5/1/77</b> Well depth <b>260</b> ft.			
					7. <input type="checkbox"/> Cable tool <input checked="" type="checkbox"/> Rotary <input type="checkbox"/> Driven <input type="checkbox"/> Dug <input type="checkbox"/> Hollow rod <input type="checkbox"/> Jetted <input type="checkbox"/> Bored <input type="checkbox"/> Reverse rotary			
					8. Use: <input checked="" type="checkbox"/> Domestic <input type="checkbox"/> Public supply <input type="checkbox"/> Industry <input type="checkbox"/> Irrigation <input type="checkbox"/> Air conditioning <input type="checkbox"/> Stock <input type="checkbox"/> Lawn <input type="checkbox"/> Oil field water <input type="checkbox"/> Other			
					9. Casing: Material <b>PHS</b> Height: <b>Above</b> or below Threaded <input type="checkbox"/> Welded <b>51</b> Surface <b>14</b> in. RMP <input type="checkbox"/> PVC <input checked="" type="checkbox"/> Weight <input type="checkbox"/> lbs./ft. Dia. <b>5</b> in. to <b>180</b> ft. depth Wall thickness: inches or Dia. <input type="checkbox"/> in. to <input type="checkbox"/> ft. depth gage No. <b>0.258</b>			
5. Type and color of material					10. Screen: Manufacturer's name <b>J+L</b> Type <b>PVC</b> Dia. <b>5"</b> Slot/gauze. <b>1/16</b> Length <b>80</b> Set between <b>180</b> ft. and <b>260</b> ft. ft. and <input type="checkbox"/> ft. Gravel pack? <b>Yes</b> Size range of material <b>1/8"</b>			
					11. Static water level: <b>148</b> ft. below land surface Date <b>5/7/77</b>			
					12. Pumping level below land surfaces: <input type="checkbox"/> ft. after <input type="checkbox"/> hrs. pumping <input type="checkbox"/> g.p.m. <input type="checkbox"/> ft. after <input type="checkbox"/> hrs. pumping <input type="checkbox"/> g.p.m. Estimated maximum yield <b>60</b> g.p.m.			
					13. Water sample submitted: <input type="checkbox"/> Yes <input checked="" type="checkbox"/> No Date <input type="checkbox"/>			
					14. Well head completion: <input type="checkbox"/> Pitless adapter <b>14</b> Inches above grade			
					15. Well grouted? <b>Yes</b> With: <input checked="" type="checkbox"/> Neat cement <input type="checkbox"/> Bentonite <input type="checkbox"/> Concrete Depth: From <b>3</b> ft. to <b>13</b> ft.			
					16. Nearest source of possible contamination: ft. <b>180</b> Direction <b>SW</b> Type <b>Septic</b> Well disinfected upon completion? <input checked="" type="checkbox"/> Yes <input type="checkbox"/> No			
					17. Pump: <input checked="" type="checkbox"/> Not installed Manufacturer's name <input type="checkbox"/> Model number <input type="checkbox"/> HP <input type="checkbox"/> Volts <input type="checkbox"/> Length of drop pipe <input type="checkbox"/> ft. capacity <input type="checkbox"/> g.p.m. Type: <input type="checkbox"/> Submersible <input type="checkbox"/> Turbine <input type="checkbox"/> Jet <input type="checkbox"/> Reciprocating <input type="checkbox"/> Centrifugal <input type="checkbox"/> Other			
18. Elevation:	(Use a second sheet if needed)				20. Water well contractor's certification: This well was drilled under my jurisdiction and this report is true to the best of my knowledge and belief. <b>T+L Water Well 142</b> Business name <input type="checkbox"/> Address <b>Box 816 Liberal, Ks.</b> License No. <b>1/4</b> Signed <b>Ch. M. Agnew</b> Date <b>6/1/77</b> Authorized representative <input type="checkbox"/>			
Topography: <input type="checkbox"/> Hill <input type="checkbox"/> Slope <input checked="" type="checkbox"/> Upland <input type="checkbox"/> Valley	17. Well to be completed by: <b>Dunham Drilling</b> <b>Copeland, Ks. 67837</b>							

Forward the white, blue and pink copies to the Department of Health and Environment

Form WWC-5