


USE TYPEWRITER OR BALL
POINT PEN-PRESS FIRMLY,
PRINT CLEARLY.

WATER WELL RECORD
KSA 82a-1201-1215

Kansas Department of Health and
Environment-Division of Environment
(Water well Contractors)
Topeka, Kansas 66620

1. Location of well:	County GARFIELD	Fraction <i>NE 1/4 SW 1/4 1/4 S. 1/4</i>	Section number <i>24</i>	Township number <i>T 27 S</i>	Range number <i>R 30 E/W</i>
2. Distance and direction from nearest town or city: south of Ingalls to 22 mile road 1/2 west 1/2 south Street address of well location if in city:	3. Owner of well: R.R. or street: City, state, zip code: Denton Unruh Montezuma, Ks. 67867				
4. Locate with "X" in section below: 	Sketch map:				
5. Type and color of material	From	To	6. Bore hole dia. <u>26</u> in. Completion date <u>2-29-76</u> Well depth <u>110</u> ft.		
7. <input type="checkbox"/> Cable tool <input type="checkbox"/> Rotary <input type="checkbox"/> Driven <input type="checkbox"/> Dug <input type="checkbox"/> Hollow rod <input type="checkbox"/> Jetted <input type="checkbox"/> Bored <input checked="" type="checkbox"/> Reverse rotary					
8. Use: <input type="checkbox"/> Domestic <input type="checkbox"/> Public supply <input type="checkbox"/> Industry <input checked="" type="checkbox"/> Irrigation <input type="checkbox"/> Air conditioning <input type="checkbox"/> Stock <input type="checkbox"/> Lawn <input type="checkbox"/> Oil field water <input type="checkbox"/> Other					
9. Casing: Material <u>STCCT</u> Height: Above or below Threaded <input type="checkbox"/> Welded <input checked="" type="checkbox"/> Surface <u>12</u> in. RMP <input type="checkbox"/> PVC <input type="checkbox"/> Weight <u>36.8</u> lbs./ft. Dia. <u>16</u> in. to <u>17</u> ft. depth Wall Thickness: inches or Dia. <u>16</u> in. to <u>17</u> ft. depth gage No. <u>25</u>					
10. Screen: Manufacturer's name <u>Johnson Division</u> Type <u>Galv.</u> Dia. <u>16"</u> Slot/gauze <u>100</u> Length <u>20'</u> Set between <u>380</u> ft. and <u>400</u> ft. Perf. <u>160-380</u> ft. and <u>400-410</u> ft. Gravel pack? <u>YES</u> Size range of material <u>25"</u> Down					
11. Static water level: <u>124</u> ft. below land surface Date <u>2-14-76</u> mo./day/yr.					
12. Pumping level below land surfaces: <u>111</u> ft. after <u>3</u> hrs. pumping <u>525</u> g.p.m. <u>111</u> ft. after <u>0</u> hrs. pumping <u>0</u> g.p.m. Estimated maximum yield <u>525</u> g.p.m.					
13. Water sample submitted: <u>NO</u> mo./day/yr. Yes <input type="checkbox"/> No <input type="checkbox"/> Date <u>2-14-76</u>					
14. Well head completion: <u>12</u> inches above grade <input type="checkbox"/> Pitless adapter <input type="checkbox"/> PVC					
15. Well grouted? <input type="checkbox"/> With: <input type="checkbox"/> Neat cement <input type="checkbox"/> Bentonite <input checked="" type="checkbox"/> Concrete Depth: From <u>0</u> ft. to <u>10</u> ft.					
16. Nearest source of possible contamination: ft. <u>0</u> Direction <u>W</u> Type <u>None</u> Well disinfected upon completion? <input type="checkbox"/> Yes <input checked="" type="checkbox"/> No					
17. Pump: <input type="checkbox"/> Not installed Manufacturer's name <u>TIC Peerless Pump</u> Model number <u>TIC</u> HP <u>200</u> Volts <u>1200</u> Length of drop pipe <u>220</u> ft. capacity <u>1200</u> g.p.m. Type: <input type="checkbox"/> Submersible <input checked="" type="checkbox"/> Turbine <input type="checkbox"/> Jet <input type="checkbox"/> Reciprocating <input type="checkbox"/> Centrifugal <input type="checkbox"/> Other					
18. Elevation: Topography: <input type="checkbox"/> Hill <input checked="" type="checkbox"/> Slope <input type="checkbox"/> Upland <input type="checkbox"/> Valley					
19. Remarks: <i>(Use a second sheet if needed)</i>					
20. Water well contractor's certification: This well was drilled under my jurisdiction and this report is true to the best of my knowledge and belief. Hinter Wilon Drilling 208 Business Name: <u>W. W. Hinter</u> Box: <u>4</u> City: <u>Garden City</u> State: <u>KS</u> Address: <u>1100 W. 10th</u> Signed: <u>W. W. Hinter</u> Date: <u>2-14-76</u> Authorized representative: <u>W. W. Hinter</u>					

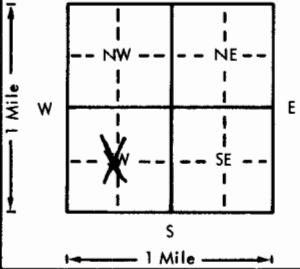

MINTER-WILSON DRILLING CO.

INCORPORATED

Irrigation
and Domestic
Water Systems
Complete Installation
and Repairing

Phone 276-8269 • P.O. Box 493 • GARDEN CITY, KANSAS 67846

DENTON UNRUH
Gray County
1-22-76

Location: SW 34-27-30
4½ Miles West Of Paul Yost house
3/10 Mile North

Static Water Level-125'

Test #1

0	2	Top Soil
2	47	Brown Sandy Clay
47	65	Fine to Med. Sand (Loose)
65	73	Fine to Med. Sand, Streaks of Clay (15%) Tight
73	94	Brown Sandy Clay
94	140	Fine to Med. Sand & Gravel (Loose)
140	134	Fine to Med Sand & Gravel, Streaks of Clay & White Rock (25%) Tight
154	178	Fine to Med. Sand & Gravel, Streaks of Clay (10%)
178	183	White Rock (Hard)
183	215	Fine to Med. Sand & Gravel (Loose)
215	230	Fine to Med. Sand & Gravel, Streaks of Clay (10%)
230	260	Brown Sandy Clay
260	276	Fine to Med. Sand & Streaks of Clay (10%) Little Tight
276	298	Brown, Sandy Clay (Tight)
298	305	Fine to Med. Sand, Streaks of Clay (15%)
305	348	Fine to Med. Sand (Little Tight)
348	410	Fine to Med. Sand & Gravel (Loose)
410	412	Gray & Yellow Clay
412	415	Shale