CORRECTION(S) TO WATER WELL RECORD (WWC-5)
(to rectify lacking or incorrect information)

County: Gray

Location listed as:	**Location ~~changed to:~~**
Section-Township-Range:	1-27S-30W
Fraction (¼ ¼ ¼):	NE SW NE

Other changes: Initial statements: Haskell County

Changed to: Gray County

Comments:

verification method: Written & legal descriptions, and county map.

initials: DRL date: 10/29/07

submitted by: Kansas Geological Survey, Data Resources Library, 1930 Constant Ave., Lawrence, KS 66047-3726
to: Kansas Dept of Health & Environment, Bureau of Water, 1000 SW Jackson, Suite 420, Topeka, KS 66612-1367.

USE TYPEWRITER OR BALL POINT PEN-PRESS FIRMLY, PRINT CLEARLY.

WATER WELL RECORD
KSA 82a-1201-1215

Kansas Department of Health and Environment-Division of Environment
(Water well Contractors)
Topeka, Kansas 66620

1. Location of well:	County	Fraction	Section number	Township number	Range number
	Haskell	NE 1/4 SW 1/4 NE 1/4	1	T 27 S	R 30 E/W

2. Distance and direction from nearest town or city: 8 south, 1 east, 1½ south, ¼ west of Charleston
Street address of well location if in city:

3. Owner of well: DeeWayne Koehn
R.R. or street:
City, state, zip code: Ingalls, Ks. 67853

4. Locate with "X" in section below:

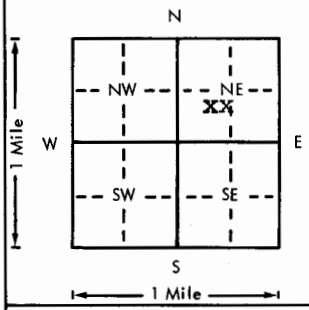

Sketch map:

6. Bore hole dia. 26 in. Completion date 4-15-77
Well depth 280 ft.

7. __ Cable tool __ Rotary __ Driven __ Dug
__ Hollow rod __ Jetted __ Bored X Reverse rotary

8. Use: __ Domestic __ Public supply __ Industry
X Irrigation __ Air conditioning __ Stock
__ Lawn __ Oil field water __ Other

9. Casing: Material steel Height: Above ~~or below~~
Threaded ___ Welded X Surface 12 in.
RMP ___ PVC ___ Weight 36.87 lbs./ft.
Dia. 16 in. to 281 ft. depth Wall Thickness: inches or
Dia. ___ in. to ___ ft. depth gage No. .250

5. Type and color of material	From	To
(Use a second sheet if needed)		

10. Screen: Manufacturer's name Johnson
Type galv. Dia. 16"
Slot/~~gauze~~ ___ Length 10 ft.
Set between 200-210 ft. and 260-270 ft.
Perf:100-200 ft. and 210-260, 270-280
Gravel pack? Yes Size range of material ½" down

11. Static water level: mo./day/yr.
73 ft. below land surface Date 4-11-77

12. Pumping level below land surfaces:
96 ft. after 2 hrs. pumping 1350 g.p.m.
105 ft. after 4 hrs. pumping 2100 g.p.m.
Estimated maximum yield 2100 g.p.m.

13. Water sample submitted: mo./day/yr.
___ Yes X No Date ___

14. Well head completion:
___ Pitless adapter 12 Inches above grade

15. Well grouted? yes
With: ___ Neat cement ___ Bentonite X Concrete
Depth: From 0 ft. to 10 ft.

16. Nearest source of possible contamination: N/A
ft. ___ Direction ___ Type ___
Well disinfected upon completion? ___ Yes X No

17. Pump: ___ Not installed
Manufacturer's name Goulds - US Pump
Model number 12JHC HP 100 Volts ___
Length of drop pipe 140 ft. capacity 1200 g.p.m.
Type:
___ Submersible X Turbine
___ Jet ___ Reciprocating
___ Centrifugal ___ Other

18. Elevation:

Topography:
___ Hill
X Slope
___ Upland
___ Valley

19. Remarks:

20. Water well contractor's certification:
This well was drilled under my jurisdiction and this report is true to the best of my knowledge and belief.
Minter-Wilson Drlg. Co. 208
Business name License No.
Address Box A Garden City, Ks.
Signed Marene DeKeyser Date 5-20-77
Authorized representative

T 27 R 30W Sec 1 NE SW NE 1/4 1/4 1/4

Forward the white, blue and pink copies to the Department of Health and Environment

Form WWC-5

MI-1023

Owner [illegible] .... ¼ .... ¼ .... ¼ sec. 1 T. .... R. ....

[illegible] Date 11-30-73 Static Water Level 75

Topo. Sheet .... Elev. .... Depth .... Yield ....

Location 75 - 44 - ½ N - ¼ W of [illegible] [illegible]

[illegible]

Formation Record No 1

Ft.	From	To	Description
	0	45	Top Soil + Fine Sand
	45	50	White Clay
	50	80	Fine Med Sand + Gravel (Loose)
	80	100	" " " Course Gravel (Loose)
	100	110	" " " Gravel (Loose)
	110	140	" " " " "
	140	155	Brn Sandy Clay
	155	185	Clay
	185	215	Fine Med Sand + Gravel (Loose)
	215	255	Brn Sandy Clay
	255	260	Fine Med Sand + Gravel (Loose)
	260	275	Med Sand + Gravel (Loose) w/ white + Brown Rock
	275	287	Clay + White Rock
	287		Shale

TD 280