

WATER WELL RECORD Form WWC-5 KSA 82a-1212

1 LOCATION OF WATER WELL:	Fraction County: GREY NL $\frac{1}{4}$ NW $\frac{1}{4}$	Section Number 1/4 2	Township Number T 27 S	Range Number R 30 E/W
---------------------------	---	----------------------------	---------------------------	--------------------------

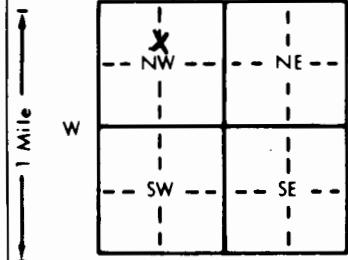
Distance and direction from nearest town or city street address of well if located within city?

2 WATER WELL OWNER:

RR#, St. Address, Box # :

City, State, ZIP Code : Ray Smith

Board of Agriculture, Division of Water Resources
Application Number: 19765

3 LOCATE WELL'S LOCATION WITH AN "X" IN SECTION BOX: 	4 DEPTH OF COMPLETED WELL .260 ft. ELEVATION: .173 ft. below land surface measured on mo/day/yr 2-27-98 Depth(s) Groundwater Encountered 1.173 ft. 2. ft. 3. ft. WELL'S STATIC WATER LEVEL .173 ft. below land surface measured on mo/day/yr 2-27-98 Pump test data: Well water was 222 ft. after 2 hours pumping .800 gpm Est. Yield .700 gpm: Well water was 245 ft. after 1 hours pumping 1.000 gpm Bore Hole Diameter .28 in. to .260 ft., and . in. to . ft. WELL WATER TO BE USED AS: 5 Public water supply 8 Air conditioning 11 Injection well 1 Domestic 3 Feedlot 6 Oil field water supply 9 Dewatering 12 Other (Specify below) 2 Irrigation 4 Industrial 7 Lawn and garden only 10 Monitoring well Was a chemical/bacteriological sample submitted to Department? Yes.....No. XX; If yes, mo/day/yr sample was submitted Water Well Disinfected? Yes XX No
--	--

5 TYPE OF BLANK CASING USED: 1 Steel 3 RMP (SR) 2 PVC 4 ABS	5 Wrought iron 8 Concrete tile 6 Asbestos-Cement 9 Other (specify below) 7 Fiberglass	CASING JOINTS: Glued XX Clamped Welded Threaded
---	---	---

Blank casing diameter .16 in. to .160 ft., Dia . in. to . ft., Dia . in. to . ft.
Casing height above land surface .12 in., weight .19.75 lbs./ft. Wall thickness or gauge No. sdr .26

TYPE OF SCREEN OR PERFORATION MATERIAL: 1 Steel 3 Stainless steel 5 Fiberglass 8 RMP (SR) 2 Brass 4 Galvanized steel 6 Concrete tile 9 ABS 7 PVC 10 Asbestos-cement 11 Other (specify) 12 None used (open hole)
--

SCREEN OR PERFORATION OPENINGS ARE: 1 Continuous slot 3 Mill slot 5 Gauzed wrapped 8 Saw cut 10 None (open hole) 2 Louvered shutter 4 Key punched 6 Wire wrapped 9 Drilled holes 7 Torch cut 10 Other (specify)
--

SCREEN-PERFORATED INTERVALS: From .160 ft. to .260 ft., From . ft. to . ft.
From . ft. to . ft., From . ft. to . ft.GRAVEL PACK INTERVALS: From .20 ft. to .260 ft., From . ft. to . ft.
From . ft. to . ft., From . ft. to . ft.

6 GROUT MATERIAL: 1 Neat cement 2 Cement grout 3 Bentonite 4 Other
--

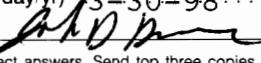
Grout Intervals: From .0 ft. to .20 ft., From . ft. to . ft., From . ft. to . ft.

What is the nearest source of possible contamination: 1 Septic tank 4 Lateral lines 7 Pit privy 10 Livestock pens 14 Abandoned water well 2 Sewer lines 5 Cess pool 8 Sewage lagoon 11 Fuel storage 15 Oil well/Gas well 3 Watertight sewer lines 6 Seepage pit 9 Feedyard 12 Fertilizer storage 16 Other (specify below)
--

Direction from well?

FROM	TO	LITHOLOGIC LOG	FROM	TO	INTERVALS
0	1	top soil	219	229	clay
1	32	sandy clay	229	234	fine sand & gravel
32	41	brown clay	234	246	fine sand with clay strip
41	82	sand & gravel	246	249	clay
82	92	yellow clay	249	261	hard rock & sand & clay str
92	106	sand & gravel			
106	117	sandy clay			
117	132	sand & gravel with clay strip			
132	189	sand & gravel			
189	198	sandstone with clay strip			
198	207	clay			
207	212	sand & gravel			
212	215	clay			
215	219	sand & gravel			

7 CONTRACTOR'S OR LANDOWNER'S CERTIFICATION: This water well was (1) constructed, (2) reconstructed, or (3) plugged under my jurisdiction and was completed on (mo/day/year) 2-25-98 and this record is true to the best of my knowledge and belief. Kansas

Water Well Contractor's License No. 367 This Water Well Record was completed on (mo/day/year) 3-30-98
under the business name of Grosch Irrigation by (signature) 

INSTRUCTIONS: Use typewriter or ball point pen. PLEASE PRESS FIRMLY and PRINT clearly. Please fill in blanks, underline or circle the correct answers. Send top three copies to Kansas Department of Health and Environment, Bureau of Water, Topeka, Kansas 66620-0001. Telephone: 913-296-5545. Send one to WATER WELL OWNER and retain one for your records.