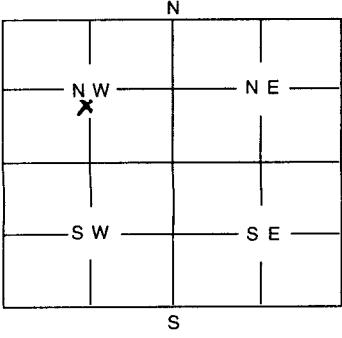


1	LOCATION OF WATER WELL:	Fraction 1/4 1/4 NW 1/4	Section Number 1	Township Number 27	Range Number 30																								
County: <u>Gray</u>																													
Distance and direction from nearest town or city street address of well if located within city?																													
2	WATER WELL OWNER:  Herman Smith 1520 3 Rd City, State, ZIP Code : Ingal's KS 67853	Board of Agriculture, Division of Water Resources Application Number:																											
3	MARK WELL'S LOCATION WITH AN "X" IN SECTION BOX:  	4	DEPTH OF WELL ..... <u>220</u> ft																										
			WELL'S STATIC WATER LEVEL ..... <u>196</u> ft.																										
			WELL WAS USED AS:																										
			1 Domestic ② Irrigation 3 Feedlot 4 Industrial	5 Public Water Supply 6 Oil Field Water Supply 7 Domestic (Lawn & Garden) 8 Air Conditioning	9 Dewatering 10 Monitoring Well 11 Injection Well 12 Other .....																								
			Was a chemical / bacteriological sample submitted to Department? Yes ..... No ..... If yes, mo/day/yr sample was submitted .....																										
			Water Well Disinfected: Yes ..... No ..... <u>X</u> .....																										
5	TYPE OF BLANK CASING USED:																												
	1 Steel 2 PVC	3 RMP (SR) 4 ABS	5 Wrought 6 Asbestos-Cement	7 Fiberglass 8 Concrete Tile	9 Other (Specify below)																								
	Blank casing diameter <u>16</u> in. Was casing pulled? Yes ..... No ..... <u>X</u> ..... If yes, how much .....																												
	Casing height above or below land surface <u>48'</u> in.																												
6	GROUT PLUG MATERIAL: 1 Neat cement 2 Cement grout 3 Bentonite 4 Other .....																												
	Grout Plug Intervals: From ..... ft. to ..... ft., From ..... ft. to ..... ft., From ..... ft. to ..... ft.																												
	What is the nearest source of possible contamination:																												
	1 Septic tank 2 Sewer lines 3 Watertight sewer lines 4 Lateral lines 5 Cess Pool	6 Seepage pit 7 Pit privy 8 Sewage lagoon 9 Feedyard 10 Livestock pens	11 Fuel storage 12 Fertilizer storage 13 Insecticide storage 14 Abandoned water well 15 Oil well/Gas well	16 Other (specify below)																									
	Direction from well? ..... How many feet? .....																												
	<table border="1"> <thead> <tr> <th>FROM</th> <th>TO</th> <th>PLUGGING MATERIALS</th> </tr> </thead> <tbody> <tr> <td><u>220'</u></td> <td><u>150'</u></td> <td><u>Course Gravel</u></td> </tr> <tr> <td><u>150'</u></td> <td><u>9'</u></td> <td><u>Clay Dirt</u></td> </tr> <tr> <td><u>9'</u></td> <td><u>4'</u></td> <td><u>Bentonite</u></td> </tr> <tr> <td><u>4'</u></td> <td></td> <td><u>Cut off at 4'</u></td> </tr> <tr> <td></td> <td></td> <td></td> </tr> <tr> <td></td> <td></td> <td></td> </tr> <tr> <td></td> <td></td> <td></td> </tr>
7	CONTRACTOR'S OR LANDOWNER'S CERTIFICATION: This water well was plugged under my jurisdiction and was completed on (mo/day/year) <u>Feb 19 2010</u> and this record is true to the best of my knowledge and belief. Kansas Water Well Contractor's License No. ..... This Water Well Record was completed on (mo/day/year) ..... under the business name of ..... by (signature) <u>Herman Smith</u>																												
INSTRUCTIONS: Use typewriter or ball point pen. Please press firmly and print clearly. Please fill in blanks, underline or circle the correct answers. Send top three copies to Kansas Department of Health and Environment, Bureau of Water, Topeka, Kansas 66620-0001. Telephone: 785/296-3565. Send one to Water Well Owner and retain one for your records.																													