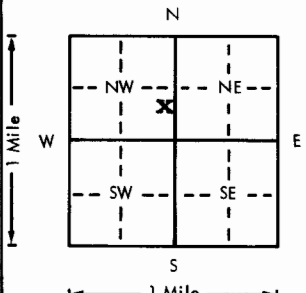


USE TYPEWRITER OR BALL
POINT PEN-PRESS FIRMLY,
PRINT CLEARLY.

WATER WELL RECORD
KSA 82a-1201-1215

Kansas Department of Health and
Environment-Division of Environment
(Water well Contractors)
Topeka, Kansas 66620

1. Location of well:	County Haskell	Fraction NE 1/4 SW 1/4 NE 1/4	Section number 21	Township number T 27 S	Range number R 31 E/W
2. Distance and direction from nearest town or city: 8 Miles E, 15 N of Sublette, Kansas Street address or well location if in city:			3. Owner of well: Loretta Mader R.R. or street: R.R. City, state, zip code: Copeland, Kansas		
4. Locate with "X" in section below:  Sketch map: 1980' South and 871 E of the NW corner of the NE 1/4, Sec. 21 T27S, R31W, Haskell, County, Ks.			6. Bore hole dia. 28 in. Completion date 8-28-76 Well depth 352 ft.		
5. Type and color of material			7. <input type="checkbox"/> Cable tool <input type="checkbox"/> Rotary <input type="checkbox"/> Driven <input type="checkbox"/> Dug <input type="checkbox"/> Hollow rod <input type="checkbox"/> Jetted <input type="checkbox"/> Bored <input checked="" type="checkbox"/> Reverse rotary		
			8. Use: <input type="checkbox"/> Domestic <input type="checkbox"/> Public supply <input type="checkbox"/> Industry <input checked="" type="checkbox"/> Irrigation <input type="checkbox"/> Air conditioning <input type="checkbox"/> Stock <input type="checkbox"/> Lawn <input type="checkbox"/> Oil field water <input type="checkbox"/> Other		
			9. Casing: Material Stl Height: Above or below Threaded <input type="checkbox"/> Welded <input checked="" type="checkbox"/> Surface 12 in. RMP <input type="checkbox"/> PVC <input type="checkbox"/> Weight 37 lbs./ft. Dia. 16 in. to 252 ft. depth Wall Thickness: inches or Dia. <input type="checkbox"/> in. to <input type="checkbox"/> ft. depth Gage No. 219		
			10. Screen: Manufacturer's name Doerr Type Louvered Dia. 16" Slot/gauze 1/8" Length 100 Set between 252 ft. and 352 ft. Gravel pack? <input checked="" type="checkbox"/> Size range of material 4.4 mm		
			11. Static water level: 118 ft. below land surface Date 6-18-76		
			12. Pumping level below land surfaces: Not pumped ____ ft. after ____ hrs. pumping ____ g.p.m. ____ ft. after ____ hrs. pumping ____ g.p.m. Estimated maximum yield 3000 g.p.m.		
			13. Water sample submitted: ____ mo./day/yr. Yes <input checked="" type="checkbox"/> No <input type="checkbox"/> Date ____		
			14. Well head completion: <input type="checkbox"/> Pitless adapter <input checked="" type="checkbox"/> Inches above grade		
			15. Well grouted? <input checked="" type="checkbox"/> With: <input type="checkbox"/> Neat cement <input checked="" type="checkbox"/> Bentonite <input type="checkbox"/> Concrete Depth: From 0 ft. to 10 ft.		
			16. Nearest source of possible contamination: unk ft. ____ Direction ____ Type ____ Well disinfected upon completion? <input checked="" type="checkbox"/> Yes <input type="checkbox"/> No		
			17. Pump: <input checked="" type="checkbox"/> Not installed Manufacturer's name ____ Model number ____ HP ____ Volts ____ Length of drop pipe ____ ft. capacity ____ g.p.m. Type: <input type="checkbox"/> Submersible <input type="checkbox"/> Turbine <input type="checkbox"/> Jet <input type="checkbox"/> Reciprocating <input type="checkbox"/> Centrifugal <input type="checkbox"/> Other		
18. Elevation:			20. Water well contractor's certification: This well was drilled under my jurisdiction and this report is true to the best of my knowledge and belief. Layne-Western Co., Inc. 102 Business name Garden City, Kansas License No. ____ Address 1214 N. 1st St. Signed Ray Vincent Date Dec 76 Authorized representative		
19. Remarks: Topography: <input type="checkbox"/> Hill <input type="checkbox"/> Slope <input checked="" type="checkbox"/> Upland <input type="checkbox"/> Valley					

Forward the white, blue and pink copies to the Department of Health and Environment

Form WWC-5