USE TYPEWRITER OR BALL POINT PEN-PRESS FIRMLY, PRINT CLEARLY.

T R EW sec 1/4 1/4 1/4 No.

WATER WELL RECORD
KSA 82a-1201-1215

Kansas State Dept. Of Health
(Water Well Contractors)
Forbes-Bldg. 740
Topeka, Kansas 66620

1 Location of well:	County	Township name	Fraction	Section number	Town number	Range number
	Haskell		SESESE	35	T27S	R 31 W

Distance and direction from nearest town or city: 9 North 2 west of Copeland, Ks
Street address of well location if in city:

3 Owner of well: James Garetson
Address: Box 55A Route 1 Copeland, Kansas

Locate with "X" in section below:

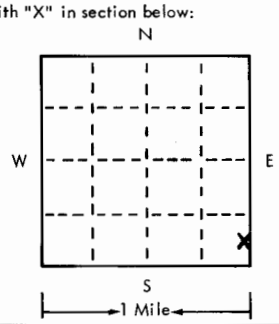

Sketch map:

4 Well depth: 300 ft. Date of completion 7/23/75
Well diameter 9 in.

5 ☐ Cable tool ☒ Rotary ☐ Driven ☐ Dug
☐ Hollow rod ☐ Jetted ☐ Bored ☐ Reverse rotary

6 Use: ☒ Domestic ☐ Public supply ☐ Industry
☐ Irrigation ☐ Air conditioning ☐ Commercial
☐ Test well ☐ _____

7 Casing: Material RMP Height: above/below
Threaded ☐ Welded ☐ Surface 14 in.
Diam. Weight 320 lbs./ft. 11
5 in. to 260 ft. depth Drive shoe? ☐ Yes ☒ No
___ in. to ___ ft. depth

2 Type and color of material	From	To
Overburden	0	150
Coarse Sand and Clay	150	220
Sand and Gravel	220	300

(use a second sheet if needed)

8 Screen:
Manufacturer J & L
Type RMP Dia. 5"
Slot/gauze 1/16 Length 40
Set between 260 ft. and 300 ft.
Fittings:
Gravel pack ☒ Yes ☐ No Size range of material 1/8

9 Static water level:
150 ft. below land surface Date 7/23/75

10 Pumping level below land surfaces:
___ ft. after ___ hrs. pumping ___ g.p.m.
___ ft. after ___ hrs. pumping ___ g.p.m.
Estimated maximum yield 60 g.p.m.

11 Water sample submitted:
☐ Yes ☒ No Date _____

12 Well head completion: 14
☐ Pitless adapter ☐ Inches above grade

13 Well grouted? ☒ Yes ☐ No
☒ Neat cement ☐ Bentonite ☐ _____
Depth: From 3 ft. to 13 ft.

14 Nearest source of possible contamination:
ft. 150 Direction W Type Corral
Well disinfected upon completion? ☒ Yes ☐ No

15 Pump: ☒ Not installed
Manufacturer's name _____
Model number _____ HP _____ Volts _____
Length of drop pipe _____ ft. capacity _____ g.m.p.
Type:
☐ Submersible ☐ Turbine
☐ Jet ☐ Reciprocating
☐ Certrifugal ☐ Other

16 Remarks: elevation

Well to be completed by:
Dunham Drilling
Copeland, Kansas

Topography:
☐ Hill
☐ Slope
☒ Upland
☐ Valley

17 Water well contractor's certification:
This well was drilled under my jurisdiction and this report is true to the best of my knowledge and belief.
T & W Water Well Service 142
Business name License No.
Address Box 816, Liberal, KS
Signed C. D. Wagnerella Date 7/23/75
Authorized representative

Forward the white, blue and pink copies to the Kansas State Dept. Of Health.

Form WWC-5

677-H