


WATER WELL RECORD Form WWC-5 KSA 82a-1212

1 LOCATION OF WATER WELL: Fraction Section Number Township Number Range Number
 COUNTY: 041 HASKELL NW 1/4 NW 1/4 SW 1/4 02 T 27 S R 31 W

Distance and direction from nearest town or city street address of well if located within city?
 FROM PLYMRELLS; 5 3/4 MILES SOUTH & 10 MILES EAST

2 WATER WELL OWNER: KLEYSTREUBER & GILLEN
 RR#, St. Address, Box #: 13060 S. ROAD 20 Board of Agriculture, Division of Water Resources
 City, State, ZIP code: GARDEN CITY, KS 67846-8805 Application Number: 27710

3 LOCATE WELL'S LOCATION WITH AN "X" IN SECTION BOX:

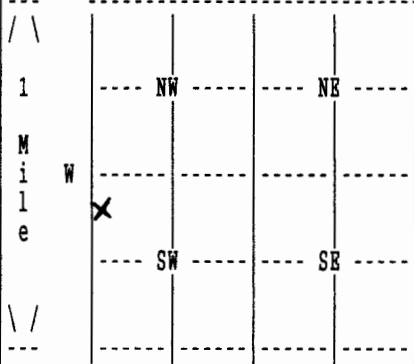

4 DEPTH OF COMPLETED WELL 355 ELEVATION: 0
 Depth(s) Groundwater Encountered 1. 0 ft. 2. 0 ft. 3. 0 ft.

WELL'S STATIC WATER LEVEL 182 ft. below land surface measured on mo/day/yr 04/15/05
 Pump test data: Well water was 226 ft. after 4 hours pumping 300 gpm

Estimated Yield 0 gpm: Well water was 0 ft. after 0 hours pumping 0 gpm

Bore Hole Diameter 24 in. to 355 ft., and in. to 0 ft.

WELL WATER TO BE USED AS: 02 IRRIGATION

Was a chemical/bacteriological sample submitted to department? No ;
 If yes, mo/day/yr sample was submitted Water well disinfected? Yes

5 TYPE OF BLANK CASING USED: 01 STEEL CASING JOINTS: WELDED
 Blank casing diameter 16 in. to 355 ft., Dia in. to 0 ft., Dia in. to 0 ft.
 Casing height above land surface 12 in., weight 42 lbs/ft. Wall thickness or gauge No. .250
 TYPE OF SCREEN OR PERFORATION MATERIAL: 01 STEEL
 SCREEN OR PERFORATION OPENINGS ARE: 01 CONT. SLOT

SCREEN PERFORATED INTERVALS: From 200 ft. to 260 ft., From 0 ft. to 0 ft.
 From 317 ft. to 337 ft., From 0 ft. to 0 ft.
 GRAVEL PACK INTERVALS: From 20 ft. to 355 ft., From 0 ft. to 0 ft.
 From 0 ft. to 0 ft., From 0 ft. to 0 ft.

6 GROUT MATERIAL 03 BENTONITE
 Grout Intervals: From 0 ft. to 20 ft., From 0 ft. to 0 ft., From 0 ft. to 0 ft.
 What is the nearest source of possible contamination: 14 ABAND. WELL
 Direction from well? SOUTHEAST How many feet? 804

FROM	TO	LITHOLOGIC LOG	FROM	TO	PLUGGING INTERVALS
0	2	02 SILT			
2	43	04 SANDY CLAY 07 FINE SAND			
43	128	05 SAND 11 GRAVEL			
128	129	01 CLAY			
129	170	05 SAND 13 FINE GRAVEL			
170	220	05 SAND			
220	235	04 SANDY CLAY			
235	239	05 SAND			
239	283	07 FINE SAND 01 CLAY			
283	313	01 CLAY			

7 CONTRACTOR'S OR LANDOWNER'S CERTIFICATION: This water well was Constructed under my jurisdiction and was completed on (mo/day/year) 04/09/05 and this record is true to the best of my knowledge and belief. Kansas Water Well Contractor's License No. 145 This Water Well Record was completed on (mo/day/yr) 06/16/05 under the business name of HENKLE DRILLING & SUPPLY by (signature)

(Continued)

WATER WELL RECORD Form WWC-5 KSA 82a-1212

1 LOCATION OF WATER WELL: COUNTY: 041 HASKELL	Fraction NW 1/4 NW 1/4 SW 1/4	Section Number 02	Township Number T 27 S	Range Number R 31 W
--	----------------------------------	----------------------	---------------------------	------------------------

2 WATER WELL OWNER: KLEYSTUBER & GILLEN
RR#, St. Address, Box # : 13060 S. ROAD 20
City, State, ZIP code : GARDEN CITY, KS 67846-8805

Board of Agriculture, Division of Water Resources
Application Number: 27710

FROM	TO	LITHOLOGIC LOG
313	326	07 FINE SAND 08 MEDIUM SAND
326	337	05 SAND 28 ROCK
337	370	31 CALICHE

7 CONTRACTOR'S OR LANDOWNER'S CERTIFICATION: This water well was Constructed under my jurisdiction and was completed on (mo/day/year) 04/09/05 and this record is true to the best of my knowledge and belief. Kansas Water Well Contractor's License No. 145 This Water Well Record was completed on (mo/day/yr) 06/16/05 under the business name of HENKLE DRILLING & SUPPLY by (signature) *Bruce J. Reichardt*