


1 LOCATION OF WATER WELL:	Fraction	Section Number	Township Number	Range Number
County: Haskell	SW 1/4 SW 1/4 SW 1/4	23	27S	31W

Distance and direction from nearest town or city street address of well if located within city?
Collingwood Grain Inc., 40 RD 1/2 WW RD, Copeland, Kansas

2 WATER WELL OWNER: Collingwood Grain, Inc.	Board of Agriculture, Division of Water Resources Application Number:
RR#, St. Address, Box # PO Box 2150	
City, State, ZIP Code : Hutchinson, KS 67504	

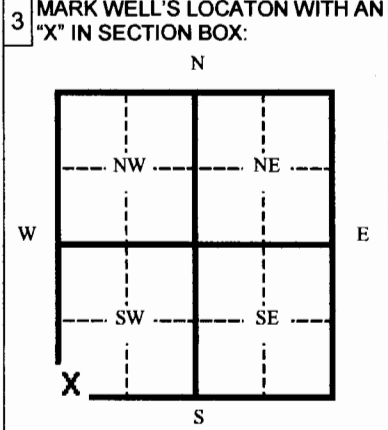

4 DEPTH OF WELL	206 ft.	
WELL'S STATIC WATER LEVEL	Dry ft.	
WELL WAS USED AS:		
1 Domestic	5 Public Water Supply	9 Dewatering
2 Irrigation	6 Oil Field Water Supply	<input checked="" type="radio"/> 10 Monitoring Well
3 Feedlot	7 Lawn and Garden (domestic)	11 Injection Well
4 Industrial	8 Air Conditioning	12 Other
Was a chemical/bacteriological sample submitted to Department? Yes ___ No <input checked="" type="checkbox"/>		
If yes, mo/day/yr sample was submitted _____		
Water Well Disinfected: Yes ___ No <input checked="" type="checkbox"/>		

5 TYPE OF BLANK CASING USED:

1 Steel	3 RMP (SR)	5 Wrought	7 Fiberglass	9 Other (specify below)
2 PVC	4 ABC	6 Asbestos-Cement	8 Concrete Tile	

Blank casing diameter **4** in. Was casing pulled? Yes ___ No If yes, how much _____

Casing height above or below land surface **-36** in.

6 GROUT PLUG MATERIAL: 1 Neat cement 2 Cement grout 3 Bentonite 4 Other _____

Grout Plug Intervals From **0** ft. to **3** ft. From **3** ft. to **206** ft. From _____ ft. to _____ ft.

- What is the nearest source of possible contamination:
- | | | | |
|--------------------------|-------------------|-------------------------|--------------------------|
| 1 Septic tank | 6 Seepage pit | 11 Fuel storage | 16 Other (specify below) |
| 2 Sewer lines | 7 Pit privy | 12 Fertilizer storage | Contaminated Site |
| 3 Watertight sewer lines | 8 Sewage lagoon | 13 Insecticide storage | |
| 4 Lateral lines | 9 Feedyard | 14 Abandoned water well | |
| 5 Cess Pool | 10 Livestock pens | 15 Oil well/ Gas well | |

Direction from well? _____ How many feet? _____

FROM	TO	CODE	PLUGGING MATERIALS
206	3		Bentonite
3	0		Cement

7 CONTRACTOR'S OR LANDOWNER'S CERTIFICATION: This water well was plugged under my jurisdiction and was completed on (mo/day/yr) **10/25/05** and this record is true to the best of my knowledge and belief. Kansas Water Well Contractor's License No. **554** This Water Well Record was completed on (mo/day/yr) **12/2/05** under the business name of **Woofter Pu mp & Well** by (signature) *[Signature]*

INSTRUCTIONS: Please fill in blanks and circle the correct answers. Send three copies to Kansas Department of Health and Environment, Bureau of Water, 1000 S W Jackson St., Ste. 420, Topeka, Kansas 66620-0001. Telephone: 785-296-3565. Send one to Water Well Owner and retain one for your records.