


HASKELL

1 LOCATION OF WATER WELL:	Fraction	Section Number	Township Number	Range Number
County: <u>SEAY</u>	<u>SE 1/4 SE 1/4 SE 1/4</u>	<u>23</u>	T <u>27</u> S	R <u>31</u> EW

Distance and direction from nearest town or city street address of well if located within city?  
COPELAND - North to Hwy 144 - 8 mi North - 2 mi West - ON NW CORNER

2 WATER WELL OWNER:	RR#, St. Address, Box #	City, State, ZIP Code	Board of Agriculture, Division of Water Resources
<u>Henry Loewen</u>	<u>Rt 1 Box 50</u>	<u>Copeland, Pa, 67837</u>	Application Number:

3 LOCATE WELL'S LOCATION WITH AN "X" IN SECTION BOX:	4 DEPTH OF COMPLETED WELL: <u>300</u> ft. ELEVATION:
--	--

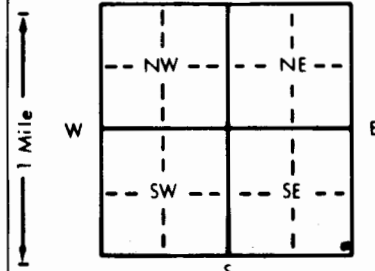

Depth(s) Groundwater Encountered 1. .... ft. 2. .... ft. 3. .... ft.

WELL'S STATIC WATER LEVEL 1.73 ft. below land surface measured on mo/day/yr 7-6-98

Pump test data: Well water was ..... ft. after ..... hours pumping ..... gpm

Est. Yield ..... gpm: Well water was ..... ft. after ..... hours pumping ..... gpm

Bore Hole Diameter 12 1/4 to 20 ft., and 9 1/4 in. to 300 in.

WELL WATER TO BE USED AS:

5 Public water supply	8 Air conditioning	11 Injection well
1 Domestic	3 Feedlot	6 Oil field water supply
2 Irrigation	4 Industrial	7 Lawn and garden only
		10 Monitoring well

Was a chemical/bacteriological sample submitted to Department? Yes..... No..... X..... If yes, mo/day/yr sample was submitted

Water Well Disinfected? Yes X No

5 TYPE OF BLANK CASING USED:	5 Wrought iron	8 Concrete tile	CASING JOINTS: Glued <u>X</u> Clamped <u>X</u>
1 Steel	3 RMP (SR)	6 Asbestos-Cement	9 Other (specify below)
2 PVC	4 ABS	7 Fiberglass	Welded
			Threaded

Blank casing diameter 5.56 in. to 240 ft., Dia. .... in. to .... ft., Dia. .... in. to .... ft.

Casing height above land surface 30 in., weight 200 lbs./ft. Wall thickness or gauge No. SDR-21

TYPE OF SCREEN OR PERFORATION MATERIAL:	7 PVC	10 Asbestos-cement
1 Steel	3 Stainless steel	5 Fiberglass
2 Brass	4 Galvanized steel	6 Concrete tile
		8 RMP (SR)
		9 ABS
		11 Other (specify)
		12 None used (open hole)

SCREEN OR PERFORATION OPENINGS ARE:	5 Gauzed wrapped	8 Saw cut	11 None (open hole)
1 Continuous slot	3 Mill slot <u>.032</u>	6 Wire wrapped	9 Drilled holes
2 Louvered shutter	4 Key punched	7 Torch cut	10 Other (specify)

SCREEN-PERFORATED INTERVALS:	From <u>240</u> ft. to <u>300</u> ft.	From ..... ft. to ..... ft.
	From ..... ft. to ..... ft.	From ..... ft. to ..... ft.

GRAVEL PACK INTERVALS:	From <u>200</u> ft. to <u>300</u> ft.	From ..... ft. to ..... ft.
	From ..... ft. to ..... ft.	From ..... ft. to ..... ft.

6 GROUT MATERIAL:	1 Neat cement	2 Cement grout	3 Bentonite	4 Other
Grout Intervals:	From <u>4</u> ft. to <u>25</u> ft.	From ..... ft. to ..... ft.	From <u>195</u> ft. to <u>200</u> ft.	

What is the nearest source of possible contamination: none

1 Septic tank	4 Lateral lines	7 Pit privy	10 Livestock pens	14 Abandoned water well
2 Sewer lines	5 Cess pool	8 Sewage lagoon	11 Fuel storage	15 Oil well/Gas well
3 Watertight sewer lines	6 Seepage pit	9 Feedyard	12 Fertilizer storage	16 Other (specify below)
			13 Insecticide storage	

Direction from well?		LITHOLOGIC LOG		PLUGGING INTERVALS	
FROM	TO	FROM	TO	FROM	TO
0	2		Topsoil		
2	14		Brown sandy clay & caliche		
14	46		Tan sandy clay		
46	75		Tan, white, brown sandy clay w/ fine sand streaks		
75	149		Med. sand, small gravel w/ tan sandy clay streaks		
149	254		Coarse sand to large gravel		
254	267		Brown sandy clay		
267	274		Sand and gravel		
274	285		Tan & white sandy clay		
285	300		Brown sandy clay w/ sand & gravel streaks		

7 CONTRACTOR'S OR LANDOWNER'S CERTIFICATION:	This water well was (1) constructed, (2) reconstructed, or (3) plugged under my jurisdiction and was completed on (mo/day/year) <u>7-6-98</u> and this record is true to the best of my knowledge and belief. Kansas Water Well Contractor's License No. <u>600A</u> This Water Well Record was completed on (mo/day/yr) <u>7-9-98</u> under the business name of <u>Cramer Drilling</u> by (signature) <u>[Signature]</u>
--	--

INSTRUCTIONS: Use typewriter or ball point pen. PLEASE PRESS FIRMLY and PRINT clearly. Please fill in blanks, underline or circle the correct answers. Send top three copies to Kansas Department of Health and Environment, Bureau of Water, Topeka, Kansas 66620-0001. Telephone: 913-296-5545. Send one to WATER WELL OWNER and retain one for your records.

OFFICE USE ONLY  
T  
R  
EW  
SEC.  
1/4  
1/4  
1/4