


WATER WELL RECORD Form WWC-5 KSA 82a-1212

1 LOCATION OF WATER WELL: Fraction Section Number Township Number Range Number  
 COUNTY: HASKELL NW 1/4 NW 1/4 SW 1/4 28 T 27 S R 31 W

Distance and direction from nearest town or city street address of well if located within city?  
 13 MILES SOUTH - 5 MILES WEST OF PIERCEVILLE, KS.

2 WATER WELL OWNER: NICHOLS, MANFORD Board of Agriculture, Division of Water Resources  
 RR#, St. Address, Box #: 354 RR ROAD Application Number:  
 City, State, ZIP code: SUBLETTE, KS 67877-

3 LOCATE WELL'S LOCATION WITH AN "X" IN SECTION BOX:

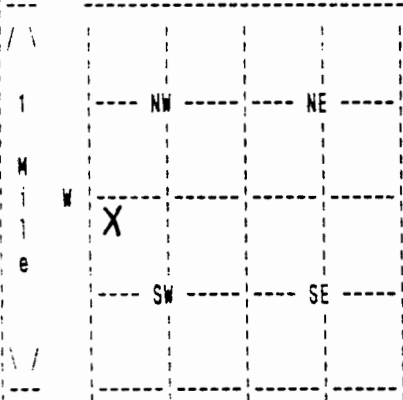

4 DEPTH OF COMPLETED WELL 485 ELEVATION: 0  
 Depth(s) Groundwater Encountered 1. 0 ft. 2. 0 ft. 3. 0 ft.

WELL'S STATIC WATER LEVEL 260 ft. below land surface measured on mo/day/yr 10/02/07  
 Pump test data: Well water was 0 ft. after 0 hours pumping 0 gpm

Estimated Yield 50 gpm: Well water was 0 ft. after 0 hours pumping 0 gpm

Bore Hole Diameter 10 in. to 485 ft., and in. to 0 ft.

WELL WATER TO BE USED AS: DOMESTIC

Was a chemical/bacteriological sample submitted to department? No ;  
 If yes, mo/day/yr sample was submitted Water well disinfected? Yes

5 TYPE OF BLANK CASING USED: CERTA LOC CASIN CASING JOINTS: CERTA-LOC  
 Blank casing diameter 5 in. to 485 ft., Dia in. to 0 ft., Dia in. to 0 ft.  
 Casing height above land surface 12 in., weight 200 lbs/ft. Wall thickness or gauge No. 21 17  
 TYPE OF SCREEN OR PERFORATION MATERIAL: PVC  
 SCREEN OR PERFORATION OPENINGS ARE: SAW CUT

SCREEN PERFORATED INTERVALS: From 360 ft. to 400 ft., From 0 ft. to 0 ft.  
 From 420 ft. to 480 ft., From 0 ft. to 0 ft.  
 GRAVEL PACK INTERVALS: From 30 ft. to 485 ft., From 0 ft. to 0 ft.  
 From 0 ft. to 0 ft., From 0 ft. to 0 ft.

6 GROUT MATERIAL BENTONITE  
 Grout Intervals: From 5 ft. to 30 ft., From 0 ft. to 0 ft., From 0 ft. to 0 ft.  
 What is the nearest source of possible contamination: NONE  
 Direction from well? How many feet? 0

FROM	TO	LITHOLOGIC LOG	FROM	TO	PLUGGING INTERVALS
0	20	01 TOPSOIL 05 CLAY			
20	80	02 FINE SAND			
80	200	37 FIN-COAR SAN 38 SMAL-MED GRA			
200	260	36 BLUE CLAY			
260	340	37 FIN-COAR SAN 06 SMALL GRAVEL			
340	400	37 FIN-COAR SAN 06 SMALL GRAVEL 17 CLAY LAYER			
400	460	10 FINE-MEDSAND 17 CLAY LAYERS			
460	500	32 TAN CLAY 26 RED CLAY 29 SANDSTONE			

7 CONTRACTOR'S OR LANDOWNER'S CERTIFICATION: This water well was Constructed under my jurisdiction and was completed on (mo/day/year) 10/03/07 and this record is true to the best of my knowledge and belief. Kansas Water Well Contractor's License No. 179 This Water Well Record was completed on (mo/day/yr) 01/16/08 under the business name of JOE'S WELL SERVICE, INC. by (signature) *Janet Crist*