


LOCATION OF WATER WELL: County: Haskell Fraction: SW 1/4 NW 1/4 NE 1/4 Section Number: 2 Township Number: T 28 S Range Number: R 31 E/W

Distance and direction from nearest town or city street address of well if located within city?
1 1/2 Miles North 2 Miles west 1/4 South

WATER WELL OWNER: Dale Tyler
 R#, St. Address, Box #: Route 1 Box 5B Board of Agriculture, Division of Water Resources
 City, State, ZIP Code: Copeland, Kansas 67837 Application Number: 13898

LOCATE WELL'S LOCATION WITH AN "X" IN SECTION BOX: DEPTH OF COMPLETED WELL: 432 ft. ELEVATION: _____

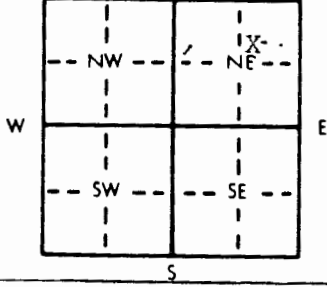

Depth(s) Groundwater Encountered 1. 355 ft. 2. 375 ft. 3. 394 ft.
 WELL'S STATIC WATER LEVEL 250 ft. below land surface measured on mo/day/yr 4-6-95
 Pump test data: Well water was _____ ft. after _____ hours pumping _____ gpm
 Est. Yield 1000 gpm: Well water was _____ ft. after _____ hours pumping _____ gpm
 Bore Hole Diameter 26 in. to 432 ft., and _____ in. to _____ ft.
 WELL WATER TO BE USED AS:
 5 Public water supply 8 Air conditioning 11 Injection well
 1 Domestic 3 Feedlot 6 Oil field water supply 9 Dewatering 12 Other (Specify below)
 2 Irrigation 4 Industrial 7 Lawn and garden only 10 Monitoring well
 Was a chemical/bacteriological sample submitted to Department? Yes _____ No X; If yes, mo/day/yr sample was submitted _____
 Water Well Disinfected? Yes X No _____

TYPE OF BLANK CASING USED:
 1 Steel 3 RMP (SR) 5 Wrought iron 8 Concrete tile CASING JOINTS: Glued X Clamped _____
 2 PVC 4 ABS 6 Asbestos-Cement 9 Other (specify below) Welded _____
 7 Fiberglass Threaded _____
 Blank casing diameter 16 in. to 372 ft., Dia _____ in. to _____ ft., Dia _____ in. to _____ ft.
 Casing height above land surface 12 in., weight _____ lbs./ft. Wall thickness or gauge No. CL160

TYPE OF SCREEN OR PERFORATION MATERIAL:
 1 Steel 3 Stainless steel 5 Fiberglass 7 PVC 10 Asbestos-cement
 2 Brass 4 Galvanized steel 6 Concrete tile 8 RMP (SR) 11 Other (specify) _____
 9 ABS 12 None used (open hole)

SCREEN OR PERFORATION OPENINGS ARE:
 1 Continuous slot 3 Mill slot 5 Gauzed wrapped 8 Saw cut 11 None (open hole)
 2 Louvered shutter 4 Key punched 6 Wire wrapped 9 Drilled holes
 7 Torch cut 10 Other (specify) _____

SCREEN-PERFORATED INTERVALS: From 372 ft. to 432 ft., From _____ ft. to _____ ft.
 From _____ ft. to _____ ft., From _____ ft. to _____ ft.
 GRAVEL PACK INTERVALS: From 20 ft. to 432 ft., From _____ ft. to _____ ft.
 From _____ ft. to _____ ft., From _____ ft. to _____ ft.

GROUT MATERIAL: 1 Neat cement 2 Cement grout 3 Bentonite 4 Other _____
 Grout Intervals: From 0 ft. to 20 ft., From _____ ft. to _____ ft., From _____ ft. to _____ ft.

What is the nearest source of possible contamination:
 1 Septic tank 4 Lateral lines 7 Pit privy 10 Livestock pens 14 Abandoned water well
 2 Sewer lines 5 Cess pool 8 Sewage lagoon 11 Fuel storage 15 Oil well/Gas well
 3 Watertight sewer lines 6 Seepage pit 9 Feedyard 12 Fertilizer storage 16 Other (specify below)
 13 Insecticide storage
 Location from well? 1/4 Mile South How many feet? _____

FROM	TO	LITHOLOGIC LOG	FROM	TO	PLUGGING INTERVALS
0	30	Topsoil & clay & little lime	255	270	Sand
30	45	Clay & little lime	270	277	Sand (little fine)
45	60	Clay & little fine sand	277	280	Clay & lime
60	75	Sand & Clay	280	285	Clay (blue)
75	105	Sand & little clay	285	335	Clay (blue)
105	120	Sand & Gravel & little clay Lime	335	338	Sand (blue)
120	135	Sand & Gravel & little clay	338	345	Clay (blue)
135	155	Sand & Gravel	345	355	Clay (blue) & little sand
155	162	Clay & little lime	355	360	Sand & clay
162	165	Sand	360	366	Sand & little clay
165	210	Sand & Gravel	366	369	Clay & little lime (hard)
210	225	Sand & 2' clay	369	375	Clay & lime
225	247	Sand (course)	375	381	Sand & cemented sand & clay
247	250	Cemented sand (hard) & clay	381	389	Clay & lime
250	255	Sand (course)	389	392	Sand

CONTRACTOR'S OR LANDOWNER'S CERTIFICATION: This water well was (1) constructed, (2) reconstructed, or (3) plugged under my jurisdiction and was completed on (mo/day/year) 4-6-95 and this record is true to the best of my knowledge and belief. Kansas Water Well Contractor's License No. 223 This Water Well Record was completed on (mo/day/yr) 5-5-95
 Under the business name of Dunham Drilling Co. by (signature) Karen Dunham

INSTRUCTIONS: Use typewriter or ball point pen. PLEASE PRESS FIRMLY and PRINT clearly. Please fill in blanks, underline or circle the correct answers. Send top three copies to Kansas Department of Health and Environment, Bureau of Water, Topeka, Kansas 66620-0001. Telephone: 913-296-5545. Send one to WATER WELL OWNER and retain one for your records.

Mr. Dale Tyler

Log Continuation

392	394	Cemented Sand (hard)
394	405	Sand (course) & 3' cemented sand (hard)
405	410	Sand
410	422	Clay
422	424	Sand
424	426	Clay
426	429	Sand (tight)
429	435	Clay