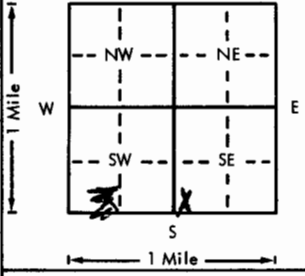


Sent 4/24/78

USE TYPEWRITER OR BALL  
POINT PEN—PRESS FIRMLY,  
PRINT CLEARLY.

WATER WELL RECORD  
KSA 82a-1201-1215

Kansas Department of Health and  
Environment—Division of Environment  
(Water well Contractors)  
Topeka, Kansas 66620

1. Location of well:		County <b>Haskell</b>	Fraction <b>SW 1/4 SE 1/4</b>	Section number <b>13</b>	Township number <b>27</b>	Range number <b>32</b>
2. Distance and direction from nearest town or city: <b>6 north, 5 east, 3 north, 1/2 east of Ulysses, Ks.</b>				3. Owner of well: <b>Vern Miller</b> R.R. or street: <b>Sublette, Ks. 67877</b> City, state, zip code:		
4. Locate with "X" in section below: 				Sketch map:		
5. Type and color of material				From	To	6. Bore hole dia. <b>27</b> in. Completion date <b>5-18-76</b> Well depth <b>369.5</b> ft. <i>See Remarks</i>
Surface				0	2	7. <input checked="" type="checkbox"/> Cable tool <input checked="" type="checkbox"/> Rotary <input type="checkbox"/> Driven <input type="checkbox"/> Dug <input type="checkbox"/> Hollow rod <input type="checkbox"/> Jetted <input type="checkbox"/> Bored <input type="checkbox"/> Reverse rotary
Fine sand				2	50	8. Use: <input type="checkbox"/> Domestic <input type="checkbox"/> Public supply <input type="checkbox"/> Industry <input checked="" type="checkbox"/> Irrigation <input type="checkbox"/> Air conditioning <input type="checkbox"/> Stock <input type="checkbox"/> Lawn <input type="checkbox"/> Oil field water <input type="checkbox"/> Other
Medium to coarse sand				50	100	9. Casing: Material <b>steel</b> Height: <b>Above or below</b> Threaded <input type="checkbox"/> Welded <input checked="" type="checkbox"/> Surface <b>14</b> in. RMP <input type="checkbox"/> PVC <input type="checkbox"/> Weight <b>36.8</b> lbs./ft. Dia. <b>0</b> in. to <b>217.1</b> ft. depth Wall thickness: inches or Dia. <b>0</b> in. to <b>217.1</b> ft. depth gauge No. <b>219</b>
Medium sand 20 ft.				100	120	10. Screen: Manufacturer's name <b>Lakewood</b> <b>Pipe of Texas</b> Type <b>steel</b> Dia. <b>16"</b> Slot/gauze <b>3/16</b> Length <b>152.4</b> Set between <b>217.1</b> ft. and <b>369.5</b> ft. ft. and <b>369.5</b> ft. Gravel pack? <input checked="" type="checkbox"/> Size range of material <b>1/4 x 5/8"</b>
Medium to coarse sand w/clay breakers 40 ft.				120	165	11. Static water level: <b>118</b> ft. below land surface Date <b>5-7-76</b> mo./day/yr.
Brown clay				165	195	12. Pumping level below land surfaces: <b>1460</b> <b>189.2</b> ft. after <b>6</b> hrs. pumping <b>1600</b> g.p.m. ft. after <b>6</b> hrs. pumping <b>1600</b> g.p.m. Estimated maximum yield <b>1460</b> <b>1600</b> g.p.m.
Blue clay				195	219	13. Water sample submitted: <b>NA</b> mo./day/yr. Yes <input checked="" type="checkbox"/> No <input type="checkbox"/> Date
Coarse sand 110 ft.				219	335	14. Well head completion: <b>NA</b> <input type="checkbox"/> Pitless adapter <input type="checkbox"/> Inches above grade
Medium sand w/clay strips 20 ft.				335	360	15. Well grouted? <input checked="" type="checkbox"/> With: <input type="checkbox"/> Neat cement <input checked="" type="checkbox"/> Bentonite <input type="checkbox"/> Concrete Depth: From <b>0</b> ft. to <b>10</b> ft.
Clay w/sand strips				360	370	16. Nearest source of possible contamination: ft. <input type="checkbox"/> Direction <input type="checkbox"/> Type <input type="checkbox"/> Well disinfected upon completion? <input type="checkbox"/> Yes <input checked="" type="checkbox"/> No
						17. Pump: <input checked="" type="checkbox"/> Not installed Manufacturer's name <input type="checkbox"/> Model number <input type="checkbox"/> HP <input type="checkbox"/> Volts <input type="checkbox"/> Length of drop pipe <input type="checkbox"/> ft. capacity <input type="checkbox"/> g.p.m. Type: <input type="checkbox"/> Submersible <input type="checkbox"/> Turbine <input type="checkbox"/> Jet <input type="checkbox"/> Reciprocating <input type="checkbox"/> Centrifugal <input type="checkbox"/> Other
(Use a second sheet if needed)						
18. Elevation:  Topography: <input type="checkbox"/> Hill <input checked="" type="checkbox"/> Slope <input type="checkbox"/> Upland <input type="checkbox"/> Valley	19. Remarks:  <b>This well has not been completely paid for and the pits have not been back filled</b>					20. Water well contractor's certification: This well was drilled under my jurisdiction and this report is true to the best of my knowledge and belief. <b>Houck Bros. Drilling Co., Inc.</b> 164 Business name License No. Address <b>Box 487, Ulysses, Ks.</b> Signed <b>M. Beard</b> Date <b>11/3/76</b> Authorized representative

Forward the white, blue and pink copies to the Department of Health and Environment

Form WWC-5