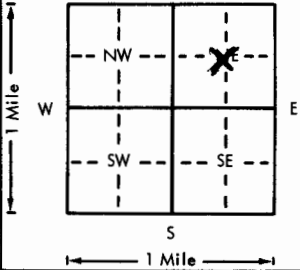


USE TYPEWRITER OR BALL
POINT PEN-PRESS FIRMLY,
PRINT CLEARLY.

WATER WELL RECORD
KSA 82a-1201-1215

Kansas Department of Health and
Environment-Division of Environment
(Water well Contractors)
Topeka, Kansas 66620

1. Location of well:	County Haskell	Fraction NE NE 1/4	Section number 17	Township number T 27 S	Range number R 32 E
2. Distance and direction from nearest town or city: 15 N. of Sublette Street address of well location if in city:			3. Owner of well: J. Greer Thompson R.R. or street: 4220 Virginia Vista City, state, zip code: Long Beach, CA 90800		
4. Locate with "X" in section below: 		Sketch map:		6. Bore hole dia. 26 in. Completion date 8-3-76 Well depth 492 ft.	
5. Type and color of material		From	To	7. <input type="checkbox"/> Cable tool <input type="checkbox"/> Rotary <input type="checkbox"/> Driven <input type="checkbox"/> Dug <input type="checkbox"/> Hollow rod <input type="checkbox"/> Jetted <input type="checkbox"/> Bored <input checked="" type="checkbox"/> Reverse rotary	
See attachment				8. Use: <input type="checkbox"/> Domestic <input type="checkbox"/> Public supply <input type="checkbox"/> Industry <input checked="" type="checkbox"/> Irrigation <input type="checkbox"/> Air conditioning <input type="checkbox"/> Stock <input type="checkbox"/> Lawn <input type="checkbox"/> Oil field water <input type="checkbox"/> Other	
				9. Casing: Material Steel Height: Above or below Threaded <input type="checkbox"/> Welded <input checked="" type="checkbox"/> Surface 12 in. RMP <input type="checkbox"/> PVC <input type="checkbox"/> Weight 36 lbs./ft. Dia. 16 in. to 492 ft. depth Wall Thickness: inches or Dia. <input type="checkbox"/> in. to <input type="checkbox"/> ft. depth gage No. .219	
				10. Screen: Manufacturer's name Brown Type Louvered Dia. 16" Slot/gauze .080 Length 152' 138' m/c Set between 402 ft. and 440 ft. 410 ft. and 310 ft. Gravel pack? Yes Size range of material 1/4 x 1/8	
				11. Static water level: 124 ft. below land surface Date 8-3-76 mo./day/yr.	
				12. Pumping level below land surfaces: 164 ft. after <input type="checkbox"/> hrs. pumping 1451 g.p.m. <input type="checkbox"/> ft. after <input type="checkbox"/> hrs. pumping <input type="checkbox"/> g.p.m. Estimated maximum yield <input type="checkbox"/> g.p.m.	
				13. Water sample submitted: <input type="checkbox"/> Yes <input checked="" type="checkbox"/> No Date <input type="checkbox"/> mo./day/yr.	
				14. Well head completion: <input type="checkbox"/> Pitless adapter 12 Inches above grade	
				15. Well grouted? Yes With: <input type="checkbox"/> Neat cement <input checked="" type="checkbox"/> Bentonite <input type="checkbox"/> Concrete Depth: From 0 ft. to 10 ft.	
				16. Nearest source of possible contamination: None observed ft. <input type="checkbox"/> Direction <input type="checkbox"/> Type <input type="checkbox"/> Well disinfected upon completion? <input type="checkbox"/> Yes <input checked="" type="checkbox"/> No	
				17. Pump: <input checked="" type="checkbox"/> Not installed Manufacturer's name <input type="checkbox"/> Model number <input type="checkbox"/> HP <input type="checkbox"/> Volts <input type="checkbox"/> Length of drop pipe <input type="checkbox"/> ft. capacity <input type="checkbox"/> g.p.m. Type: <input type="checkbox"/> Submersible <input type="checkbox"/> Turbine <input type="checkbox"/> Jet <input type="checkbox"/> Reciprocating <input type="checkbox"/> Centrifugal <input type="checkbox"/> Other	
				(Use a second sheet if needed)	
18. Elevation: Flat Topography: <input type="checkbox"/> Hill <input type="checkbox"/> Slope <input type="checkbox"/> Upland <input type="checkbox"/> Valley	19. Remarks:			20. Water well contractor's certification: This well was drilled under my jurisdiction and this report is true to the best of my knowledge and belief. Henkle Drlg. & Supply 145 Business name <input type="checkbox"/> License No. <input type="checkbox"/> Address Box 639 Garden City, KS Signed E.L. Bothwell Date 8-12-76 Authorized representative	

Forward the white, blue and pink copies to the Department of Health and Environment

Form WWC-5

DRILLERS TEST LOG

CUSTOMERS NAME J. Greer Thompson DATE 7-12-76
 STREET ADDRESS 4220 Virginia Vista TEST # 1 E. Log 500'
 CITY & STATE Long Beach, CA DRILLER Rector
 COUNTY Haskell QUARTER NE SECTION 17 TOWNSHIP 27 RANGE 32

LOCATION Center of 1/4

WELL LOCATION

%	FOOTAGE			Description of Strata	Static Water Level
	From	Pay	To		Proposed Well Depth
	0		3	Top soil	
	3		38	Brown clay	
	38		200	Sand and gravel, used lots of water, mud heavy, few rock ledges	
55	200	7	207	Sand, brown clay and few cemented sts.	
	207		238	Blue clay	
30	238	12	250	Sand fine med. coarse and med. small gravel, cemented st. at 240'	
	250		257	Blue clay, sand sts. and few lime rock ledges	
40	257	7	264	Blue sand, fine med. coarse, loose, used water	
	264		286	Blue clay, sticky	
	286		310	Blue clay, gyp rock and sandstone sts.	
65	310	61	371	Sand fine med. coarse and small gravel, very few gyp and clay sts., loose, used lots of water	
	371		378	Brown clay and lime rock	
40	378	5	383	Sand fine med. coarse, loose, used water	
	383		390	Brown clay and lime rock	
45	390	30	420	Sand fine med. coarse, small coarse, brown sandy clay, fairly loose, used water	
	420		440	Brown clay	
40	440	10	450	Sand fine med. coarse, small coarse, and brown sandy clay, used little water	
50	450	5	455	Brown sandstone and brown rock, used water	
	455		470	Brown and yellow clay	
Good	470		490	Brown sandstone, soapstone and sts. of brown rock and sts. of red shale, firm, used water	
	490		495	Blue shale	
	495		500	Blue shale and limestone, very hard	
		157			
				TOTAL DEPTH OF WELL 492 FT.	
				Set up north	
				Pit on east	

ORDEN CITY, KANSAS HENKLE DRILLING & SUPPLY CO., INC. SUBLETTE, KANSAS
 ONE 276-327. IRRIGATION HEADQUARTERS PHONE 675-4311

ST HOLES*****STOCK WELLS*****IRRIGATION AND INDUSTRIAL WELLS*****