WATER WELL RECORD Form WWC-5 KSA 82a-1212

1 LOCATION OF WATER WELL: County: Haskell	Fraction: SE ¼ SE ¼ SE ¼	Section Number: 20	Township Number: T 27 S	Range Number: R 32 E(W)

Distance and direction from nearest town or city street address of well if located within city?
Approx. 14 miles North and 1 3/4 miles East of Sublette

2 WATER WELL OWNER: Tee Inc. - c/o James Thompson
RR#, St. Address, Box # : 312 Canyon Drive
City, State, ZIP Code : Portola Valley, California 94025

Board of Agriculture, Division of Water Resources Application Number:

3 LOCATE WELL'S LOCATION WITH AN "X" IN SECTION BOX:

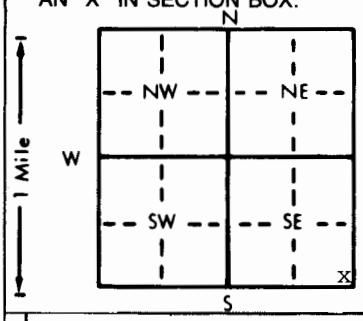

4 DEPTH OF COMPLETED WELL 380' ft. ELEVATION:
Depth(s) Groundwater Encountered 1. ft. 2. ft. 3. ft.
WELL'S STATIC WATER LEVEL 179' ft. below land surface measured on mo/day/yr
Pump test data: Well water was ft. after hours pumping gpm
Est. Yield 25 gpm: Well water was ft. after hours pumping gpm
Bore Hole Diameter 9 7/8 in. to 380' ft., and in. to ft.
WELL WATER TO BE USED AS: 1 Domestic 2 Irrigation 3 Feedlot 4 Industrial 5 Public water supply 6 Oil field water supply 7 Lawn and garden only 8 Air conditioning 9 Dewatering 10 Observation well 11 Injection well 12 Other (Specify below)
Was a chemical/bacteriological sample submitted to Department? Yes No x; If yes, mo/day/yr sample was submitted
Water Well Disinfected? Yes x No

5 TYPE OF BLANK CASING USED: 1 Steel 2 PVC 3 RMP (SR) 4 ABS 5 Wrought iron 6 Asbestos-Cement 7 Fiberglass 8 Concrete tile 9 Other (specify below)
CASING JOINTS: Glued x Clamped Welded Threaded
Blank casing diameter 5" in. to 380' ft., Dia in. to ft., Dia in. to ft.
Casing height above land surface 12" in., weight 2.9 lbs./ft. Wall thickness or gauge No. .265
TYPE OF SCREEN OR PERFORATION MATERIAL: 1 Steel 2 Brass 3 Stainless steel 4 Galvanized steel 5 Fiberglass 6 Concrete tile 7 PVC 8 RMP (SR) 9 ABS 10 Asbestos-cement 11 Other (specify) 12 None used (open hole)
SCREEN OR PERFORATION OPENINGS ARE: 1 Continuous slot 2 Louvered shutter 3 Mill slot 4 Key punched 5 Gauzed wrapped 6 Wire wrapped 7 Torch cut 8 Saw cut 9 Drilled holes 10 Other (specify) 11 None (open hole)
SCREEN-PERFORATED INTERVALS: From 210' ft. to 230' ft., From ft. to ft.
From 320' ft. to 380' ft., From ft. to ft.
GRAVEL PACK INTERVALS: From 10' ft. to 380' ft., From ft. to ft.
From ft. to ft., From ft. to ft.

6 GROUT MATERIAL: 1 Neat cement 2 Cement grout 3 Bentonite 4 Other
Grout Intervals: From 0 ft. to 10' ft., From ft. to ft., From ft. to ft.
What is the nearest source of possible contamination: 1 Septic tank 2 Sewer lines 3 Watertight sewer lines 4 Lateral lines 5 Cess pool 6 Seepage pit 7 Pit privy 8 Sewage lagoon 9 Feedyard 10 Livestock pens 11 Fuel storage 12 Fertilizer storage 13 Insecticide storage 14 Abandoned water well 15 Oil well/Gas well 16 Other (specify below)
Direction from well? East How many feet? 100'

FROM	TO	LITHOLOGIC LOG	FROM	TO	LITHOLOGIC LOG
		See Attached Log			

7 CONTRACTOR'S OR LANDOWNER'S CERTIFICATION: This water well was (1) constructed, (2) reconstructed, or (3) plugged under my jurisdiction and was completed on (mo/day/year) February 13, 1986 and this record is true to the best of my knowledge and belief. Kansas Water Well Contractor's License No. 145 This Water Well Record was completed on (mo/day/yr) February 17, 1986 under the business name of Henkle Drilling & Supply Co., Inc. by (signature) Bruce Reichmuth

INSTRUCTIONS: Use typewriter or ball point pen, *PLEASE PRESS FIRMLY* and *PRINT* clearly. Please fill in blanks, underline or circle the correct answers. Send top three copies to Kansas Department of Health and Environment, Division of Environment, Environmental Geology Section, Topeka, KS 66620. Send one to WATER WELL OWNER and retain one for your records.

OFFICE USE ONLY T R E/W SEC. ¼ ¼ ¼

DRILLERS TEST LOG

CUSTOMERS NAME Tee Inc. - c/o James Thompson DATE 2-11-86
STREET ADDRESS 312 Canyon Drive TEST # 1 E. LOG yes
CITY & STATE Portola Valley, CA 94025 DRILLER Livingston
COUNTY Haskell QUARTER SE SECTION 20 TOWNSHIP 27 RANGE 32

LOCATION 1 - Se Corner of Section

%	FOOTAGE From	Pay	To	DESCRIPTION OF STRATA — Static Water Level ____ Proposed Well Depth ____
	0		2	Top Soil
	2		21	Brown Sandy Clay
	21		41	Sand fine to medium
	41		60	Brown Clay
	60		181	Sand fine to medium, small to large gravel and few clay stks.
	181		200	Brown clay, and few sand stks.
65	200	31	231	Sand fine to medium, coarse, small gravel and few clay stks.
	231		246	Brown clay
	246		300	Blue Clay
	300		320	Blue clay and limerock ledges
	320		338	Blue clay, sand fine to medium, coarse, stks.
45	338	14	352	Sand fine to medium, coarse, small gravel and brown sandy clay
	352		358	Brown sandy clay
65	358	10	368	Sand fine to medium, coarse, small to medium gravel
	368		373	Brown sandy clay
50	373	11	384	Sand fine to medium, coarse, small gravel
	384		400	Brown sandy clay and limerock
				TOTAL DEPTH 380'
				5" PVC
				PERF PLAIN
				380-320 60'
				320-230 90'
				230-210 20'
				210-0 210'
				Total 80' 300'
				#1 Fine Gravel Pack
				1-50# Celca