


1 LOCATION OF WATER WELL: Fraction NE 1/4 SE 1/4 SW 1/4 Section Number 35 Township Number T 27 S Range Number R 32 E/W

Distance and direction from nearest town or city street address of well if located within city? Approx. 12 miles north and 2 miles east of Sublette, KS

2 WATER WELL OWNER: Manford Nichols RR#, St. Address, Box #: HCR, Box 48A City, State, ZIP Code: Sublette, KS 67877 Board of Agriculture, Division of Water Resources Application Number: 12,463 & 20,095

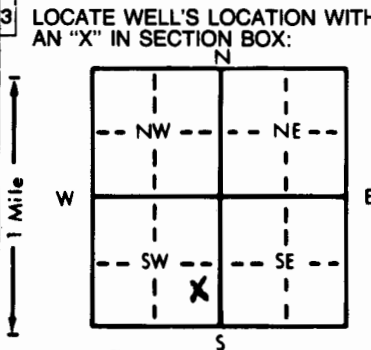

4 DEPTH OF COMPLETED WELL: 577' ft. ELEVATION: ... WELL'S STATIC WATER LEVEL: 294' ft. below land surface measured on mo/day/yr ... Pump test data: Well water was 365' ft. after 24 hours pumping 1025 gpm ... Est. Yield 1100 gpm ... Bore Hole Diameter 24" in. to 577' ft. and ... WELL WATER TO BE USED AS: 5 Public water supply 8 Air conditioning 11 Injection well 1 Domestic 3 Feedlot 6 Oil field water supply 9 Dewatering 12 Other (Specify below) 2 Irrigation 4 Industrial 7 Lawn and garden only 10 Observation well ... Was a chemical/bacteriological sample submitted? Yes No X; If yes, mo/day/yr sample was submitted ... Water Well Disinfected? Yes No X

5 TYPE OF BLANK CASING USED: 1 Steel 3 RMP (SR) 5 Wrought iron 8 Concrete tile CASING JOINTS: Glued Clamped 2 PVC 4 ABS 6 Asbestos-Cement 9 Other (specify below) Welded 7 Fiberglass Threaded ... Blank casing diameter 16" in. to 577' ft. Dia 16" in. to 577' ft. Dia ... Casing height above land surface 12" in., weight 42.05 lbs./ft. Wall thickness or gauge No. 250" w ... TYPE OF SCREEN OR PERFORATION MATERIAL: 1 Steel 3 Stainless steel 5 Fiberglass 8 RMP (SR) 10 Asbestos-cement 2 Brass 4 Galvanized steel 6 Concrete tile 9 ABS 11 Other (specify) 12 None used (open hole) ... SCREEN OR PERFORATION OPENINGS ARE: 1 Continuous slot 3 Mill slot 5 Gauzed wrapped 8 Saw cut 11 None (open hole) 2 Louvered shutter 4 Key punched 6 Wire wrapped 9 Drilled holes 7 Torch cut 10 Other (specify) ... SCREEN-PERFORATED INTERVALS: From 317-357 ft. to 450-490 ft. From 370-430 ft. to 513-577 ft. ... GRAVEL PACK INTERVALS: From 20' ft. to 577' ft.

6 GROUT MATERIAL: 1 Neat cement 2 Cement grout 3 Bentonite 4 Other Grout Intervals: From 0 ft. to 20' ft. From ... What is the nearest source of possible contamination: 1 Septic tank 4 Lateral lines 7 Pit privy 10 Livestock pens 14 Abandoned water well 2 Sewer lines 5 Cess pool 8 Sewage lagoon 11 Fuel storage 15 Oil well/Gas well 3 Watertight sewer lines 6 Seepage pit 9 Feedyard 12 Fertilizer storage 16 Other (specify below) 13 Insecticide storage ... Direction from well? How many feet? NONE OBSERVED

Table with columns FROM, TO, LITHOLOGIC LOG. Contains the text 'SEE ATTACHED LOG' in the center.

7 CONTRACTOR'S OR LANDOWNER'S CERTIFICATION: This water well was (1) constructed, (2) reconstructed, or (3) plugged under my jurisdiction and was completed on (mo/day/year) 7-20-87 and this record is true to the best of my knowledge and belief. Kansas Water Well Contractor's License No. 145. This Water Well Record was completed on (mo/day/yr) 7-31-87 under the business name of Henkle Drilling & Supply Co., Inc. by (signature) Orval Reichardt

INSTRUCTIONS: Use typewriter or ball point pen. PLEASE PRESS FIRMLY and PRINT clearly. Please fill in blanks, underline or circle the correct answers. Send top three copies to Kansas Department of Health and Environment, Office of Oil Field and Environmental Geology, Regulation and Permitting Section, Topeka, Kansas 66620-7500, Telephone: 913-862-9360. Send one to WATER WELL OWNER and retain one for your records.

DRILLERS TEST LOG

CUSTOMERS NAME Manford Nichols DATE 7-13-87  
 STREET ADDRESS \_\_\_\_\_ TEST # 142 E. LOG YES  
 CITY & STATE Sublette, KS 67877 DRILLER Livingston  
 COUNTY Haskell QUARTER SW SECTION 35 TOWNSHIP 27 RANGE 32  
 LOCATION 525 ft. east of old well

| %  | FOOTAGE |        | DESCRIPTION OF STRATA   | Static Water Level <u>225'</u> |                    |
|----|---------|--------|---|--------------------------------|--------------------|
|    | From    | Pay To |   | Proposed Well Depth _____      |                    |
|    | 0       | 2      | Top Soil  |                                |                    |
|    | 2       | 101    | Brown sandy clay, caliche and few sand stks.  |                                |                    |
|    | 101     | 169    | Sand, fine to medium, small to large gravel, few clay stks., and cemented ledges            |                                |                    |
|    | 169     | 173    | Brown sandy clay  |                                |                    |
| 55 | 173     | 233    | Sand, fine to medium, coarse, small gravel and few clay stks and rock ledges                |                                |                    |
|    | 233     | 251    | Yellow clay and limerock ledges   |                                |                    |
| 45 | 251     | 262    | Sand, fine to medium, coarse  |                                |                    |
|    | 262     | 288    | Brown sandy clay, limerock ledges   |                                |                    |
|    | 288     | 193    | Blue clay   |                                |                    |
| 50 | 293     | 331    | Sand, fine to medium, coarse, small gravel and brown sandy clay, limerock                   |                                |                    |
| 60 | 331     | 341    | Sand, fine to medium, coarse, small to medium gravel and cemented ledges and few clay stks. |                                |                    |
|    | 341     | 347    | Brown sandy clay and limerock   |                                |                    |
| 70 | 347     | 357    | Sand, fine to medium, coarse, small to medium gravel and drills rough                       |                                |                    |
|    | 357     | 380    | Brown sandy clay, limerock  |                                |                    |
| 60 | 380     | 392    | Sand, fine to medium, coarse, small gravel  |                                |                    |
|    | 392     | 400    | Brown sandy clay, limerock  |                                |                    |
| 50 | 400     | 410    | Sand, fine to medium, coarse, small gravel few clay stks.                                   |                                |                    |
|    | 410     | 420    | Brown sandy clay  |                                |                    |
| 45 | 420     | 425    | Sand, fine to medium, coarse  |                                |                    |
|    | 425     | 515    | Brown sandy clay, limerock and few fine sand stks   |                                |                    |
| 80 | 518     | 534    | Sand, fine to medium, coarse, small to medium brown gravel and brown rock - drills rough    |                                |                    |
|    | 534     | 538    | Brown clay  |                                |                    |
| 35 | 538     | 570    | Sandstone and soapstone + lost circulation at 548'  |                                |                    |
|    |         |        | Mixed 10 Jel and 1 Bran   |                                |                    |
|    | 570     | 580    | Soapstone and limestone   |                                |                    |
|    |         |        | Moved test hole #2, 20 ft. north  |                                |                    |
|    |         |        | Mixed 15 Jel and 3 Bran   |                                | Drill Big Hole     |
|    |         |        |   |                                | between test holes |
|    |         |        | Set Up - Northwest  |                                |                    |
|    |         |        | Don't get on SE 1/4   |                                |                    |