

WATER WELL PLUGGING RECORD Form WWC-5P

KSA 82a-1212

ID NO.

N/A

1 LOCATION OF WATER WELL: County: **HASKELL** Fraction $\frac{1}{4}$ SE $\frac{1}{4}$ NW $\frac{1}{4}$ NE $\frac{1}{4}$ Section Number **6** Township Number **T 27 S** Range Number **32** ☐ E ☒ W

Street/Rural Address of Well Location; if unknown, distance & direction from nearest town or intersection: If at owner's address, check here ☐ From Hwy 83 & E Haskell County Line

Road; approx. 3/4 mile East then approx. 1/4 mile South

Global Positioning Systems (GPS) information:
Latitude: **37.73381** (in decimal degrees)
Longitude: **100.85759** (in decimal degrees)
Elevation: _____

Datum: ☐ WGS84, ☐ NAD83, ☒ NAD27


Collection Method:

☐ GPS unit (Make/Model: **Garmen eTrex 10**)
☐ Digital Map/Photo, ☐ Topographic Map, ☐ Land Survey

Est. Accuracy: ☐ < 3 m, ☐ 3-5 m, ☐ 5-15 m, ☐ > 15 m

2 WATER WELL OWNER: **Edna Collingwood Trust**
RR#, St. Address, Box #: **P.O. Box 1184**
City, State ZIP Code: **Hutchinson Ks., 67504**

3 MARK WELL'S LOCATION WITH AN "X" IN SECTION BOX:

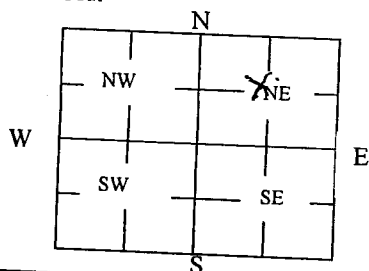

4 DEPTH OF WELL **208'** ft.

WELL'S STATIC WATER LEVEL **No Water** ft

WELL WAS USED AS:

☒ Domestic ☐ Public Water Supply ☐ Dewatering
☐ Irrigation ☐ Oil Field Water Supply ☐ Monitoring
☐ Feedlot ☐ Domestic (Lawn & Garden) ☐ Injection Well
☐ Industrial ☐ Air Conditioning ☐ Other _____

Was a chemical/bacteriological sample submitted to Department? Yes ☐ No ☒

5 TYPE OF BLANK CASING USED:

☒ Steel ☐ RMP (SR) ☐ Wrought ☐ Fiberglass ☐ Other (Specify below)
☐ PVC ☐ ABS ☐ Asbestos-Cement ☐ Concrete Tile

Blank casing diameter **16"** in. Was casing pulled? Yes ☒ No ☐ If yes, how much **60"**
Casing height above or below land surface **Below 60"** in.

6 GROUT PLUG MATERIAL: ☐ Neat cement ☒ Cement grout ☐ Bentonite ☐ Other _____
Grout Plug Intervals: From **10'** ft. to **5'** ft., From _____ ft. to _____ ft., From _____ to _____ ft.

What is the nearest source of possible contamination:

☐ Septic tank ☐ Seepage pit ☐ Fuel Storage ☒ Other (specify below)
☐ Sewer lines ☐ Pit privy ☐ Fertilizer storage ☐ None Observed
☐ Watertight sewer lines ☐ Sewage lagoon ☐ Insecticide storage
☐ Lateral lines ☐ Feedyard ☐ Abandoned water well
☐ Cess pool ☐ Livestock pens ☐ Oil well/Gas well

Direction from well? _____
How many feet? _____

FROM	TO	PLUGGING MATERIALS	FROM	TO	PLUGGING MATERIALS
208'	10'	Oversized Rock w/Clay Chunks	10'	5'	3,000 PSI Concrete
5'	0'	Cut off casing and backfilled			

7 CONTRACTOR'S OR LANDOWNER'S CERTIFICATION: This water well was plugged under my jurisdiction and was completed on (mo/day/year) **11-6-2018** and this record is true to the best of my knowledge and belief. Kansas Water Well Contractor's License No. **145**. This Water Well Record was completed on (mo/day/year) **11-9-2018** under the business name of **Hydro Resources Mid Continent** by (signature) **Gary Clepper**

INSTRUCTIONS: Use typewriter or ballpoint pen. Please press firmly and print clearly. Please fill in blanks, underline or circle the correct answers. Send top three copies to Kansas Department of Health and Environment, Bureau of Water, Geology Section, 1000 SW Jackson St., Ste. 420, Topeka, Kansas 66612-1367. Telephone: 785/296-5524. Send one to Water Well Owner and retain one for your records. Visit us at <http://www.kdheks.gov/waterwell/index.html>.

Check one: ☐ White Copy ☐ Blue Copy ☐ Pink Copy