


1 LOCATION OF WATER WELL: County: **Haskell** Fraction: **NW 1/4 SE 1/4 SW 1/4** Section Number: **19** Township Number: **T 27 S** Range Number: **R 33 EW**

Distance and direction from nearest town or city street address of well if located within city? **From west side of Sublette - 1 mile SW on Hwy. 56, 14 miles north, 5 miles west, 680 ft. north & 3,498 ft. west**

2 WATER WELL OWNER: **William L. and Judith Ann Engler**  
 RR#, St. Address, Box #: **1905 Harding St.** Board of Agriculture, Division of Water Resources  
 City, State, ZIP Code: **Garden City, Kansas 67846** Application Number: **12,520**

3 LOCATE WELL'S LOCATION WITH AN "X" IN SECTION BOX:

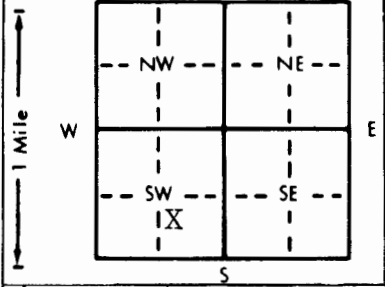

4 DEPTH OF COMPLETED WELL: **577** ft. ELEVATION:

Depth(s) Groundwater Encountered 1. . . . . ft. 2. . . . . ft. 3. . . . . ft.  
 WELL'S STATIC WATER LEVEL **301** ft. below land surface measured on **mo/day/yr 11-12-96**  
 Pump test data: Well water was . . . . . ft. after . . . . . hours pumping . . . . . gpm  
 Est. Yield . . . . . gpm: Well water was . . . . . ft. after . . . . . hours pumping . . . . . gpm  
 Bore Hole Diameter: **30** in. to **577** ft., and . . . . . in. to . . . . . ft.  
 WELL WATER TO BE USED AS: 5 Public water supply 8 Air conditioning 11 Injection well  
 1 Domestic 3 Feedlot 6 Oil field water supply 9 Dewatering 12 Other (Specify below)  
 Irrigation 4 Industrial 7 Lawn and garden only 10 Monitoring well . . . . .  
 Was a chemical/bacteriological sample submitted to Department? Yes . . . . . No ; If yes, mo/day/yr sample was submitted  
 Water Well Disinfected? Yes No

5 TYPE OF BLANK CASING USED: 5 Wrought iron 8 Concrete tile CASING JOINTS: Glued . . . . . Clamped . . . . .  
 Steel 3 RMP (SR) 6 Asbestos-Cement 9 Other (specify below) Welded   
 2 PVC 4 ABS 7 Fiberglass from **387 ft.** Threaded from **487 ft.**

Blank casing diameter **16** in. to **307** ft., Dia. **16** in. to **427** ft., Dia. **16** in. to **532** ft.  
 Casing height above land surface **12** in., weight **42.05** lbs./ft. Wall thickness or gauge No. **250**

TYPE OF SCREEN OR PERFORATION MATERIAL: 7 PVC 10 Asbestos-cement  
 Steel 3 Stainless steel 5 Fiberglass 8 RMP (SR) 11 Other (specify) . . . . .  
 2 Brass 4 Galvanized steel 6 Concrete tile 9 ABS 12 None used (open hole)

SCREEN OR PERFORATION OPENINGS ARE: 5 Gauzed wrapped 8 Saw cut 11 None (open hole)  
 1 Continuous slot  Mill slot  Wire wrapped 9 Drilled holes  
 2 Louvered shutter 4 Key punched 7 Torch cut 10 Other (specify) . . . . .

SCREEN-PERFORATED INTERVALS: From **307** ft. to **387** ft., From **427** ft. to **487** ft.  
 From **532** ft. to **577** ft., From . . . . . ft. to . . . . . ft.  
 GRAVEL PACK INTERVALS: From **20** ft. to **235** ft., From **295** ft. to **577** ft.  
 From . . . . . ft. to . . . . . ft., From . . . . . ft. to . . . . . ft.

6 GROUT MATERIAL: 1 Neat cement  Cement grout 3 Bentonite 4 Other . . . . .  
 Grout Intervals: From **0** ft. to **20** ft., From **235** ft. to **295** ft., From . . . . . ft. to . . . . . ft.

What is the nearest source of possible contamination:  
 1 Septic tank 4 Lateral lines 7 Pit privy 10 Livestock pens 14 Abandoned water well  
 2 Sewer lines 5 Cess pool 8 Sewage lagoon 11 Fuel storage 15 Oil well/Gas well  
 3 Watertight sewer lines 6 Seepage pit 9 Feedyard 12 Fertilizer storage 16 Other (specify below)  
 13 Insecticide storage . . . . .  
 Direction from well? How many feet? **N/A**

FROM	TO	LITHOLOGIC LOG	FROM	TO	PLUGGING INTERVALS
		See attached log			

7 CONTRACTOR'S OR LANDOWNER'S CERTIFICATION: This water well was  constructed,  reconstructed, or  plugged under my jurisdiction and was completed on (mo/day/year) **11-18-96** and this record is true to the best of my knowledge and belief. Kansas Water Well Contractor's License No. **208** This Water Well Record was completed on (mo/day/yr) **11-26-96** under the business name of **Minter-Wilson Drilling Co., Inc.** by (signature) **Nora Keller**

INSTRUCTIONS: Use typewriter or ball point pen. PLEASE PRESS FIRMLY and PRINT clearly. Please fill in blanks, underline or circle the correct answers. Send top three copies to Kansas Department of Health and Environment, Bureau of Water, Topeka, Kansas 66620-0001. Telephone: 913-296-5545. Send one to WATER WELL OWNER and retain one for your records.