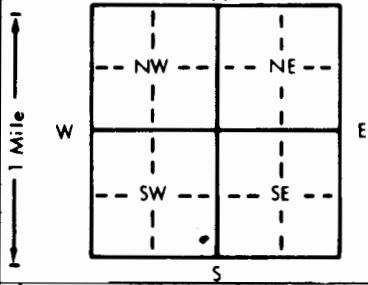


1 LOCATION OF WATER WELL: County: HASKELL Fraction: NW 1/4 SE 1/4 SW 1/4 Section Number: 19 Township Number: T 27 S Range Number: R 33 EW

Distance and direction from nearest town or city street address of well if located within city?
Jct 83 & 56 @ Sublette - 17 mi North on Hwy 83 - 5 1/2 mi West - 1/8 mi North & West ->

2 WATER WELL OWNER: JUNIOR WRIGHT
 RR#, St. Address, Box #: Route 1 Box 95 Board of Agriculture, Division of Water Resources
 City, State, ZIP Code: SATANTA, KANSAS 67870 Application Number:

3 LOCATE WELL'S LOCATION WITH AN "X" IN SECTION BOX:


4 DEPTH OF COMPLETED WELL: 560 ft. ELEVATION:
 Depth(s) Groundwater Encountered 1. 290' ft. 2. _____ ft. 3. _____ ft.
 WELL'S STATIC WATER LEVEL _____ ft. below land surface measured on mo/day/yr
 Pump test data: Well water was _____ ft. after _____ hours pumping _____ gpm
 Est. Yield _____ gpm: Well water was _____ ft. after _____ hours pumping _____ gpm
 Bore Hole Diameter: 12 1/4 in. to 18 ft., and 10 1/4 in. to 560 ft.
 WELL WATER TO BE USED AS: 5 Public water supply 8 Air conditioning 11 Injection well
 1 Domestic 3 Feedlot 6 Oil field water supply 9 Dewatering 12 Other (Specify below)
 2 Irrigation 4 Industrial 7 Lawn and garden only 10 Monitoring well
 Was a chemical/bacteriological sample submitted to Department? Yes _____ No X If yes, mo/day/yr sample was submitted
 Water Well Disinfected? Yes X No

5 TYPE OF BLANK CASING USED:
 1 Steel 3 RMP (SR) 5 Wrought iron 8 Concrete tile CASING JOINTS: Glued X Clamped _____
 2 PVC 4 ABS 6 Asbestos-Cement 9 Other (specify below) Welded _____
 7 Fiberglass Threaded _____
 Blank casing diameter 6.56 in. to 500 ft., Dia _____ in. to _____ ft., Dia _____ in. to _____ ft.
 Casing height above land surface 30 in., weight 200 lbs./ft. Wall thickness or gauge No. SDR-21
 TYPE OF SCREEN OR PERFORATION MATERIAL:
 1 Steel 3 Stainless steel 5 Fiberglass 7 PVC 10 Asbestos-cement
 2 Brass 4 Galvanized steel 6 Concrete tile 8 RMP (SR) 11 Other (specify) _____
 12 None used (open hole)
 SCREEN OR PERFORATION OPENINGS ARE:
 1 Continuous slot 3 Mill slot .035 5 Gauzed wrapped 8 Saw cut 11 None (open hole)
 2 Louvered shutter 4 Key punched 6 Wire wrapped 9 Drilled holes
 7 Torch cut 10 Other (specify) _____
 SCREEN-PERFORATED INTERVALS: From 500 ft. to 560 ft., From _____ ft. to _____ ft.
 From _____ ft. to _____ ft., From _____ ft. to _____ ft.
 GRAVEL PACK INTERVALS: From 470 ft. to 560 ft., From _____ ft. to _____ ft.
 From _____ ft. to _____ ft., From _____ ft. to _____ ft.

6 GROUT MATERIAL: 1 Neat cement 2 Cement grout 3 Bentonite 4 Other _____
 Grout Intervals: From 5 ft. to 27 ft., From 460 ft. to 470 ft., From _____ ft. to _____ ft.
 What is the nearest source of possible contamination:
 1 Septic tank 4 Lateral lines 7 Pit privy 10 Livestock pens 14 Abandoned water well
 2 Sewer lines 5 Cess pool 8 Sewage lagoon 11 Fuel storage 15 Oil well/Gas well
 3 Watertight sewer lines 6 Seepage pit 9 Feedyard 12 Fertilizer storage 16 Other (specify below)
 13 Insecticide storage
 Direction from well? South How many feet? 200

FROM	TO	LITHOLOGIC LOG	FROM	TO	PLUGGING INTERVALS
0	3	Top Soil	472	496	MED - COARSE SAND w/ TAN CLAY - 4'
3	79	TAN SANDY CLAY w/ FINE SAND - 34'	496	532	COARSE SAND - SMALL GRAVEL
79	92	COARSE SAND	532	560	SANDSTONE w/ SANDY CLAY STREAKS
92	235	FINE SAND - Med. GRAVEL			
235	289	Cemented SAND & GRAVEL w/ SANDSTONE			
289	310	TAN CLAY			
310	317	COARSE SAND			
317	338	TAN SANDY CLAY w/ Cemented - SAND & GRAVEL			
338	397	TAN CLAY w/ FINE SAND - 21'			
387	439	TAN & WHITE CLAY w/ FINE SAND - 19'			
439	456	FINE - MED. SAND			
456	465	TAN CLAY			
465	472	BLUE CLAY			

7 CONTRACTOR'S OR LANDOWNER'S CERTIFICATION: This water well was (1) constructed, (2) reconstructed, or (3) plugged under my jurisdiction and was completed on (mo/day/year) 6-10-97 and this record is true to the best of my knowledge and belief. Kansas Water Well Contractor's License No. 600-A This Water Well Record was completed on (mo/day/yr) 6-23-97 under the business name of CRAMER Drlg. Co. by (signature) Ray Cramer