


1 LOCATION OF WATER WELL: County: Haskell	Fraction NE 1/4 NE 1/4 NW 1/4	Section Number 1	Township Number T 27 S	Range Number R 33W EW
-----------------------------------------------------	-----------------------------------------	----------------------------	----------------------------------	---------------------------------

Distance and direction from nearest town or city street address of well if located within city? **Sublette, Kansas - North 18 miles to Haskell County-Finney County Line - 3/4 mi. West - South of tank batt to locat**

2 WATER WELL OWNER: RR#, St. Address, Box # : City, State, ZIP Code :	Eugene Davis Star Route Box 36 Sublette, KS	Beredco/ Berexco Board of Agriculture, Division of Water Resources Application Number: T 88-16
-----------------------------------------------------------------------------	------------------------------------------------------------------------	---

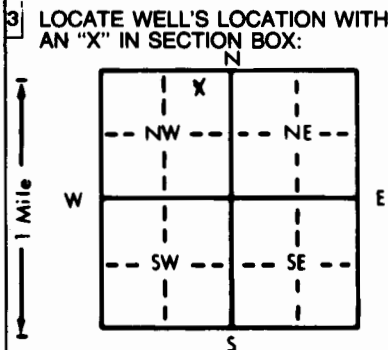

4 DEPTH OF COMPLETED WELL: 340 ft. ELEVATION:
Depth(s) Groundwater Encountered 1. 167 ft. 2. ft. 3. ft.
WELL'S STATIC WATER LEVEL 167 ft. below land surface measured on mo/day/yr 01/13/88
Pump test data: Well water was ft. after hours pumping gpm
Est. Yield 85 gpm: Well water was ft. after hours pumping gpm
Bore Hole Diameter 9" in. to 340' ft., and in. to ft.
WELL WATER TO BE USED AS:
1 Domestic 3 Feedlot 6 Oil field water supply 9 Dewatering 12 Other (Specify below)
2 Irrigation 4 Industrial 7 Lawn and garden only 10 Observation well
Was a chemical/bacteriological sample submitted to Department? Yes.....No. X; If yes, mo/day/yr sample was submitted
Water Well Disinfected? Yes X No

5 TYPE OF BLANK CASING USED:	1 Steel	3 RMP (SR)	6 Asbestos-Cement	9 Other (specify below)	Welded
	2 PVC	4 ABS	7 Fiberglass		Threaded
Blank casing diameter 5.563 in. to 200 ft., Dia. in. to ft., Dia. in. to ft.					
Casing height above land surface -48" in., weight 2.93 lbs./ft. Wall thickness or gauge No. 265					
TYPE OF SCREEN OR PERFORATION MATERIAL:	1 Steel	3 Stainless steel	5 Fiberglass	8 RMP (SR)	11 Other (specify)
	2 Brass	4 Galvanized steel	6 Concrete tile	9 ABS	12 None used (open hole)
SCREEN OR PERFORATION OPENINGS ARE:	1 Continuous slot	3 Mill slot	6 Wire wrapped	9 Drilled holes	11 None (open hole)
	2 Louvered shutter	4 Key punched	7 Torch cut	10 Other (specify)	
SCREEN-PERFORATED INTERVALS: From 200 ft. to 240 ft., From 280 ft. to 340 ft.					
GRAVEL PACK INTERVALS: From 160 ft. to 340 ft.					

6 GROUT MATERIAL: 1 Neat cement	2 Cement grout	3 Bentonite	4 Other
Grout Intervals: From 4 ft. to 160 ft., From ft. to ft., From ft. to ft.			
What is the nearest source of possible contamination:	1 Septic tank	4 Lateral lines	7 Pit privy
	2 Sewer lines	5 Cess pool	8 Sewage lagoon
	3 Watertight sewer lines	6 Seepage pit	9 Feedyard
			10 Livestock pens
			11 Fuel storage
			12 Fertilizer storage
			13 Insecticide storage
			14 Abandoned water well
			15 Oil well/Gas well
			16 Other (specify below)
Direction from well? East		How many feet? 165'	

FROM	TO	LITHOLOGIC LOG	FROM	TO	LITHOLOGIC LOG
0	4	Clay & Dirt	.55		cu. feet of clay & dirt
4	160	Bentonite Grout	21.28		cu. feet of Bentonite Grout
160	340	Chlorinated Sand	24.55		cu. feet of Chlorinated sand

7 CONTRACTOR'S OR LANDOWNER'S CERTIFICATION: This water well was (1) constructed, (2) reconstructed, or (3) plugged under my jurisdiction and was completed on (mo/day/year) 02/19/88 and this record is true to the best of my knowledge and belief. Kansas Water Well Contractor's License No. 118 This Water Well Record was completed on (mo/day/yr) 02/23/88 under the business name of Carlile Water Well Service, Inc. by (signature) <i>[Signature]</i>

INSTRUCTIONS: Use typewriter or ball point pen. PLEASE PRESS FIRMLY and PRINT clearly. Please fill in blanks, underline or circle the correct answers. Send top three copies to Kansas Department of Health and Environment, Bureau of Water Protection, Topeka, Kansas 66620-7320, Telephone: 913-862-9360. Send one to WATER WELL OWNER and retain one for your records.