


1 LOCATION OF WATER WELL: County: Haskell	Fraction SE 1/4 NW 1/4 SW 1/4	Section Number 1	Township Number T 27 S	Range Number R 33 E/W
---	---	----------------------------	----------------------------------	--

Distance and direction from nearest town or city street address of well if located within city?

North of Sublette to Finney-Haskell County line on HWY 83 1/2 West 3/4 South West into

2 WATER WELL OWNER: Violet K #1 RR#, St. Address, Box # : City, State, ZIP Code :	Beredco Inc. 401 E. Douglas Ste. 402 Wichita, KS 67202	Board of Agriculture, Division of Water Resources Application Number: T89-008
--	--	---

3 LOCATE WELL'S LOCATION WITH AN "X" IN SECTION BOX:

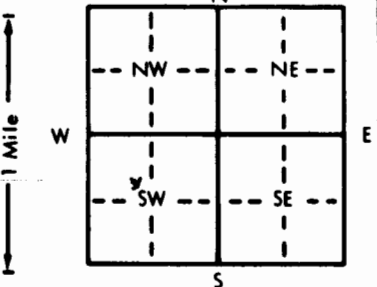

4 DEPTH OF COMPLETED WELL: **330** ft. ELEVATION:

Depth(s) Groundwater Encountered **1** ft. 2. ft. 3. ft.

WELL'S STATIC WATER LEVEL **180** ft. below land surface measured on mo/day/yr **1-10-89**

Pump test data: Well water was ft. after hours pumping gpm

Est. Yield gpm: Well water was ft. after hours pumping gpm

Bore Hole Diameter in. to ft., and in. to ft.

WELL WATER TO BE USED AS:

5 Public water supply	8 Air conditioning	11 Injection well
1 Domestic	3 Feedlot	6 Oil field water supply
2 Irrigation	4 Industrial	7 Lawn and garden only
		10 Monitoring well
		12 Other (Specify below)

Was a chemical/bacteriological sample submitted to Department? Yes.....No.....; If yes, mo/day/yr sample was submitted

Water Well Disinfected? Yes No

5 TYPE OF BLANK CASING USED:

1 Steel	3 RMP (SR)	6 Asbestos-Cement	9 Other (specify below)	CASING JOINTS: Glued	Clamped
2 PVC	4 ABS	7 Fiberglass		Welded	
				Threaded	

Blank casing diameter **5** in. to **0-230** ft., Dia. in. to ft., Dia. in. to ft.

Casing height above land surface in., weight lbs./ft. Wall thickness or gauge No.

TYPE OF SCREEN OR PERFORATION MATERIAL:

1 Steel	3 Stainless steel	5 Fiberglass	7 PVC	10 Asbestos-cement
2 Brass	4 Galvanized steel	6 Concrete tile	8 RMP (SR)	11 Other (specify)
			9 ABS	12 None used (open hole)

SCREEN OR PERFORATION OPENINGS ARE:

1 Continuous slot	3 Mill slot	5 Gauzed wrapped	8 Saw cut	11 None (open hole)
2 Louvered shutter	4 Key punched	6 Wire wrapped	9 Drilled holes	
		7 Torch cut	10 Other (specify)	

SCREEN-PERFORATED INTERVALS: From **230** ft. to **330** ft., From ft. to ft.

GRAVEL PACK INTERVALS: From ft. to ft., From ft. to ft.

6 GROUT MATERIAL: 1 Neat cement 2 Cement grout 3 Bentonite 4 Other

Grout Intervals: From ft. to ft., From ft. to ft., From ft. to ft.

What is the nearest source of possible contamination:

1 Septic tank	4 Lateral lines	7 Pit privy	10 Livestock pens	14 Abandoned water well
2 Sewer lines	5 Cess pool	8 Sewage lagoon	11 Fuel storage	15 Oil well/Gas well
3 Watertight sewer lines	6 Seepage pit	9 Feedyard	12 Fertilizer storage	16 Other (specify below)
			13 Insecticide storage	

Direction from well? **West** How many feet? **225**

FROM	TO	LITHOLOGIC LOG	FROM	TO	PLUGGING INTERVALS
330	170	Sand			
170	160	Cement			
160	23	Sand			
23	3	Cement			
3	0	Topsoil			

7 CONTRACTOR'S OR LANDOWNER'S CERTIFICATION: This water well was (1) constructed, (2) reconstructed, or (3) **plugged under my jurisdiction and was** completed on (mo/day/year) **2-27-89** and this record is true to the best of my knowledge and belief. Kansas Water Well Contractor's License No. **142** This Water Well Record was completed on (mo/day/yr) **3-2-89** under the business name of **T & W Water Well Service, Inc.** by (signature) *C. W. Wagers*

INSTRUCTIONS: Use typewriter or ball point pen. PLEASE PRESS FIRMLY and PRINT clearly. Please fill in blanks, underline or circle the correct answers. Send top three copies to Kansas Department of Health and Environment, Bureau of Water Protection, Topeka, Kansas 66620-7320. Telephone: 913-296-5514. Send one to WATER WELL OWNER and retain one for your records.