


1 LOCATION OF WATER WELL: Fraction **NE 1/4 NE 1/4 NE 1/4** Section Number **2** Township Number **T 27 S** Range Number **R 33 E** **(W)**  
 County: **Haskell**

Distance and direction from nearest town or city street address of well if located within city?

**15 South 1 West of Garden City, KS**

2 WATER WELL OWNER: **Gene Davis**  
 RR#, St. Address, Box #: **HCR 1, Box 36** Board of Agriculture, Division of Water Resources  
 City, State, ZIP Code: **Sublette, KS 67877** Application Number:

3 LOCATE WELL'S LOCATION WITH AN "X" IN SECTION BOX:

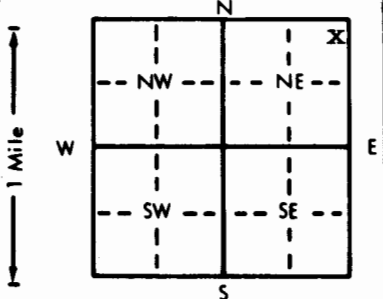

4 DEPTH OF COMPLETED WELL: **330** ft. ELEVATION: ..... ft.  
 Depth(s) Groundwater Encountered 1. **170** ft. 2. .... ft. 3. .... ft.  
 WELL'S STATIC WATER LEVEL **160** ft. below land surface measured on mo/day/yr **5-16-89**  
 Pump test data: Well water was **175** ft. after **2** hours pumping **30** gpm  
 Est. Yield **20** gpm: Well water was ..... ft. after ..... hours pumping ..... gpm  
 Bore Hole Diameter **9** in. to **330** ft., and ..... in. to ..... ft.  
 WELL WATER TO BE USED AS: 5 Public water supply 8 Air conditioning 11 Injection well  
 1 Domestic 3 Feedlot 6 Oil field water supply 9 Dewatering 12 Other (Specify below)  
 2 Irrigation 4 Industrial 7 Lawn and garden only 10 Monitoring well .....  
 Was a chemical/bacteriological sample submitted to Department? Yes.....No.. **X**.....; If yes, mo/day/yr sample was submitted  
 Water Well Disinfected? Yes **X** No

5 TYPE OF BLANK CASING USED: 5 Wrought iron 8 Concrete tile CASING JOINTS: Glued **X** Clamped .....  
 1 Steel 3 RMP (SR) 6 Asbestos-Cement 9 Other (specify below) Welded .....  
 2 PVC 4 ABS 7 Fiberglass Threaded .....  
 Blank casing diameter **5** in. to **0-290** ft., Dia ..... in. to ..... ft., Dia ..... in. to ..... ft.  
 Casing height above land surface **14** in., weight **200** lbs./ft. Wall thickness or gauge No. **0, 265**

TYPE OF SCREEN OR PERFORATION MATERIAL: **7 PVC** 10 Asbestos-cement  
 1 Steel 3 Stainless steel 5 Fiberglass 8 RMP (SR) 11 Other (specify) .....  
 2 Brass 4 Galvanized steel 6 Concrete tile 9 ABS 12 None used (open hole)

SCREEN OR PERFORATION OPENINGS ARE: 5 Gauzed wrapped 8 Saw cut 11 None (open hole)  
 1 Continuous slot 3 Mill slot 6 Wire wrapped 9 Drilled holes  
 2 Louvered shutter 4 Key punched 7 Torch cut 10 Other (specify) **Factory Perf.**

SCREEN-PERFORATED INTERVALS: From **290** ft. to **330** ft., From ..... ft. to ..... ft.  
 From ..... ft. to ..... ft., From ..... ft. to ..... ft.  
 GRAVEL PACK INTERVALS: From **150** ft. to **330** ft., From ..... ft. to ..... ft.  
 From ..... ft. to ..... ft., From ..... ft. to ..... ft.

6 GROUT MATERIAL: 1 Neat cement 2 Cement grout 3 Bentonite 4 Other .....  
 Grout Intervals: From **0** ft. to **20** ft., From ..... ft. to ..... ft., From ..... ft. to ..... ft.  
 What is the nearest source of possible contamination:  
 1 Septic tank 4 Lateral lines 7 Pit privy 10 Livestock pens 14 Abandoned water well  
 2 Sewer lines 5 Cess pool 8 Sewage lagoon 11 Fuel storage 15 Oil well/Gas well  
 3 Watertight sewer lines 6 Seepage pit 9 Feedyard 12 Fertilizer storage 16 Other (specify below)  
 13 Insecticide storage .....  
 Direction from well? **South** How many feet? **1/8 mile**

FROM	TO	LITHOLOGIC LOG	FROM	TO	PLUGGING INTERVALS
0	160	Overburden			
160	180	Gravel			
180	200	Medium sand and gravel			
200	220	Medium sand			
220	240	Medium sand			
240	260	Medium sand			
260	280	Medium sand			
280	300	Medium sand			
300	330	Medium sand and clay			

7 CONTRACTOR'S OR LANDOWNER'S CERTIFICATION: This water well was (1) constructed, (2) reconstructed, or (3) plugged under my jurisdiction and was completed on (mo/day/year) **5-16-89** and this record is true to the best of my knowledge and belief. Kansas Water Well Contractor's License No. **142** This Water Well Record was completed on (mo/day/yr) **5-51-89** under the business name of **T & W Water Well Service, Inc.** by (signature) *CD Waymiller*