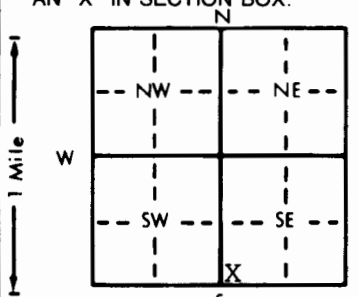


1 LOCATION OF WATER WELL: Fraction SW 1/4 SW 1/4 SE 1/4 Section Number 29 Township Number T 27 S Range Number R 33 E W

Distance and direction from nearest town or city street address of well if located within city?
 N/Sublette to Hitch Feeders Rd, 4W, 1S, 1/2W & N into-

2 WATER WELL OWNER: Friesen Windmill & Supply Russell Kells
 RR#, St. Address, Box # : 215 N Post Board of Agriculture, Division of Water Resources
 City, State, ZIP Code : Meade, KS 67864 Application Number:

3 LOCATE WELL'S LOCATION WITH AN "X" IN SECTION BOX:  DEPTH OF COMPLETED WELL... 540 ft. ELEVATION: ...
 Depth(s) Groundwater Encountered 1... 230 ft. 2... ft. 3... ft.
 WELL'S STATIC WATER LEVEL ... 230 ft. below land surface measured on mo/day/yr ... 1/20/93
 Pump test data: Well water was ... ft. after ... hours pumping ... gpm
 Est. Yield .50... gpm: Well water was ... ft. after ... hours pumping ... gpm
 Bore Hole Diameter... 15 in. to ... 540 ft., and ... in. to ... ft.
 WELL WATER TO BE USED AS: 5 Public water supply 8 Air conditioning 11 Injection well
 Domestic 3 Feedlot 6 Oil field water supply 9 Dewatering 12 Other (Specify below)
 2 Irrigation 4 Industrial 7 Lawn and garden only 10 Monitoring well
 Was a chemical/bacteriological sample submitted to Department? Yes... No... X...; If yes, mo/day/yr sample was submitted
 Water Well Disinfected? Yes X No

5 TYPE OF BLANK CASING USED: 5 Wrought iron 8 Concrete tile CASING JOINTS: Glued X Clamped
 1 Steel 3 RMP (SR) 6 Asbestos-Cement 9 Other (specify below) Welded
 2 PVC 4 ABS 7 Fiberglass Threaded
 Blank casing diameter ... 8 in. to ... 540 ft., Dia ... in. to ... ft., Dia ... in. to ... ft.
 Casing height above land surface ... 24 in., weight ... 2.902 lbs./ft. Wall thickness or gauge No. .280. SDR=21
 TYPE OF SCREEN OR PERFORATION MATERIAL: 7 PVC 10 Asbestos-cement
 1 Steel 3 Stainless steel 5 Fiberglass 8 RMP (SR) 11 Other (specify)
 2 Brass 4 Galvanized steel 6 Concrete tile 9 ABS 12 None used (open hole)
 SCREEN OR PERFORATION OPENINGS ARE: 5 Gauzed wrapped 8 Saw cut 11 None (open hole)
 1 Continuous slot 3 Mill slot 6 Wire wrapped 9 Drilled holes
 2 Louvered shutter 4 Key punched 7 Torch cut 10 Other (specify)
 SCREEN-PERFORATED INTERVALS: From ... 460 ft. to ... 540 ft., From ... ft. to ... ft.
 From ... ft. to ... ft., From ... ft. to ... ft.
 GRAVEL PACK INTERVALS: From ... 35 ft. to ... 540 ft., From ... ft. to ... ft.
 From ... ft. to ... ft., From ... ft. to ... ft.

6 GROUT MATERIAL: 1 Neat cement 2 Cement grout 3 Bentonite 4 Other Hole Plug
 Grout Intervals: From ... 1 ft. to ... 20 ft., From ... ft. to ... ft., From ... ft. to ... ft.
 What is the nearest source of possible contamination:
 1 Septic tank 4 Lateral lines 7 Pit privy 10 Livestock pens 14 Abandoned water well
 2 Sewer lines 5 Cess pool 8 Sewage lagoon 11 Fuel storage 15 Oil well/Gas well
 3 Watertight sewer lines 6 Seepage pit 9 Feedyard 12 Fertilizer storage 16 Other (specify below)
 13 Insecticide storage

Direction from well? How many feet?

FROM	TO	LITHOLOGIC LOG	FROM	TO	PLUGGING INTERVALS
0	3	Surface Soil			
3	94	Clay			
94	145	Sand & Gravel			
145	177	Clay & Gravel			
177	232	Clay			
232	291	Sand			
291	318	Blue Clay			
318	415	Sand			
415	477	Sand & Clay			
477	486	Sand			
486	518	Sand & Clay			
518	540	Sand & Gravel			

7 CONTRACTOR'S OR LANDOWNER'S CERTIFICATION: This water well was (1) constructed, (2) reconstructed, or (3) plugged under my jurisdiction and was completed on (mo/day/year) ... 1/20/93 ... and this record is true to the best of my knowledge and belief. Kansas Water Well Contractor's License No. ... KWWCL-430 ... This Water Well Record was completed on (mo/day/yr) ... 1/20/93 ... under the business name of Howard Drlg. Co. Box 806 Beaver, OK 73932 by (signature) *Howard Drlg. Co.*

INSTRUCTIONS: Use typewriter or ball point pen. PLEASE PRESS FIRMLY and PRINT clearly. Please fill in blanks, underline or circle the correct answers. Send top three copies to Kansas Department of Health and Environment, Bureau of Water, Topeka, Kansas 66620-0001. Telephone: 913-296-5545. Send one to WATER WELL OWNER and retain one for your records.