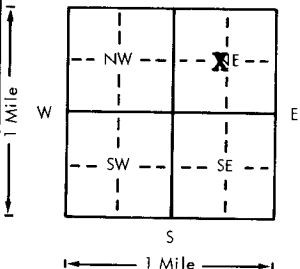


USE TYPEWRITER OR BALL  
POINT PEN-PRESS FIRMLY,  
PRINT CLEARLY.

WATER WELL RECORD  
KSA 82a-1201-1215

Kansas Department of Health and  
Environment-Division of Environment  
(Water well Contractors)  
Topeka, Kansas 66620

1. Location of well:		County <b>Haskell County</b>	Fraction <b>1/4 <del>SE</del> <sup>NE</sup></b>	Section number <b>11</b>	Township number <b>T 27 S</b>	Range number <b>R 34 W</b>
2. Distance and direction from nearest town or city: <b>1/4 South of Garden City</b> Street address of well location if in city:				3. Owner of well: <b>Fern Batchelder</b> R.R. or street: <b>1706 B</b> City, state, zip code: <b>Garden City, KS 67846</b>		
4. Locate with "X" in section below:		Sketch map:		6. Bore hole dia. <b>26</b> in. Completion date <b>5-20-79</b> Well depth <b>370</b> ft.		
				7. Cable tool <input type="checkbox"/> Rotary <input type="checkbox"/> Driven <input type="checkbox"/> Dug <input type="checkbox"/> Hollow rod <input type="checkbox"/> Jetted <input type="checkbox"/> Bored <input checked="" type="checkbox"/> Reverse rotary		
5. Type and color of material				8. Use: Domestic <input type="checkbox"/> Public supply <input type="checkbox"/> Industry <input checked="" type="checkbox"/> Irrigation <input type="checkbox"/> Air conditioning <input type="checkbox"/> Stock <input type="checkbox"/> Lawn <input type="checkbox"/> Oil field water <input type="checkbox"/> Other		
				9. Casing: Material <b>Steel</b> Height: Above or below Threaded <input type="checkbox"/> Welded <input checked="" type="checkbox"/> Surface <b>1</b> ft. in. RMP <input type="checkbox"/> PVC <input type="checkbox"/> Weight <b>36.87</b> lbs./ft. Dia. <b>16</b> in. to <b>370</b> ft. depth Wall Thickness: inches or Dia. <input type="checkbox"/> in. to <input type="checkbox"/> ft. depth Gage No. <b>.219</b>		
				10. Screen: Manufacturer's name <b>Johnson</b> Type <b>Johnson Galv.</b> Dia. <b>100-16"</b> Slot/gauze <b>0-170 Plain</b> Length <b>170-300 Perf.</b> Set between <b>300-320 Screen 320-370 ft. Perf.</b> Gravel pack? <b>yes</b> Size range of material: <b>1/4 to 5/8</b>		
				11. Static water level: <input type="checkbox"/> mo./day/yr. <b>138</b> ft. below land surface Date <b>4-13-79</b>		
				12. Pumping level below land surfaces: <b>143</b> ft. after <b>2</b> hrs. pumping <b>1000</b> p.m. <b>145</b> ft. after <b>4</b> hrs. pumping <b>1500</b> p.m. Estimated maximum yield <b>1500</b> g.p.m.		
				13. Water sample submitted: <input type="checkbox"/> Yes <input checked="" type="checkbox"/> No Date		
				14. Well head completion: <input type="checkbox"/> Pitless adapter <input checked="" type="checkbox"/> <b>1</b> ft. Inches above grade		
				15. Well grouted <b>yes</b> With: <input type="checkbox"/> Neat cement <input type="checkbox"/> Bentonite <input checked="" type="checkbox"/> Concrete Depth: From <b>0</b> ft. to <b>10</b> ft.		
				16. Nearest source of possible contamination: ft. <input type="checkbox"/> Direction <b>N/A</b> Type <input type="checkbox"/> Well disinfected upon completion? <input type="checkbox"/> Yes <input type="checkbox"/> No		
				17. Pump: <input type="checkbox"/> Not installed Manufacturer's name <b> Gould 6 stg. 12" JHC Bowl</b> Model number <b>H125</b> Volts <input type="checkbox"/> Length of drop pipe <b>220</b> ft. capacity <b>1000</b> g.p.m. Type: <input type="checkbox"/> Submersible <input checked="" type="checkbox"/> Turbine <input type="checkbox"/> Jet <input type="checkbox"/> Reciprocating <input type="checkbox"/> Centrifugal <input type="checkbox"/> Other		
18. Elevation:		19. Remarks:		20. Water well contractor's certification: This well was drilled under my jurisdiction and this report is true to the best of my knowledge and belief. <b>Minter Wilson Drilling Co. 208</b> Business name <b>B6x A, Garden City, KS</b> License No. <b>67846</b> Address <b>6/27/79</b> Signature <b>Michael Minter</b> Date <b>6/27/79</b> Authorized representative		

Forward the white, blue and pink copies to the Department of Health and Environment

Form WWC-5

# MINTER-WILSON DRILLING CO.

INCORPORATED

Commercial  
and Domestic  
Water Systems  
Complete Installation  
and Repairing

Phone: 276-8269

P.O. Box A

GARDEN CITY, KANSAS 67846

February 10, 1979

Fern Batchelder  
Haskell County

Location: N. E.  $\frac{1}{4}$  11-27-34 30' North of Well stake  
Static Water Level -

Test #2

0	23	Top Soil Fine Sand
23	61	Brown Sandy Clay
61	110	Fine to med. sand and gravel 10% Clay
110	132	Med. coarse gravel
132	155	Med. coarse gravel 10% Clay
155	190	Fine to med. sand and gravel (loose)
190	232	Fine to med. sand and gravel streak of coarse gravel (loose)
232	260	Brown Sandy Clay 10% Coarse gravel
260	280	Brown Sandy Clay
280	288	Fine to med. sand and gravel (loose)
288	324	Med. coarse gravel
324	361	Brown Sandy Clay
361	369	Fine to med. sand and gravel
369	384	Brown Sandy Clay
384	409	Brown gray Clay
409	423	Brown Yellow Clay hard

T. D. 370