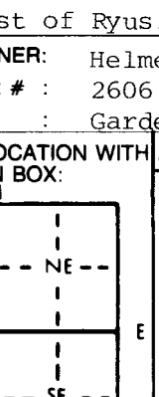


1 LOCATION OF WATER WELL:		Fraction	Section Number	Township Number	Range Number
County: Haskell	NW ¼ NW ¼ SW ¼	15	T 27 S R 34 E W		
Distance and direction from nearest town or city street address of well if located within city? Approximately 9½ North and 4 miles East of Ryus.					
2 WATER WELL OWNER: Helmerich & Payne, Inc. RR#, St. Address, Box # : 2606 Fleming City, State, ZIP Code : Garden City, Ks. 67846 <div style="text-align: right;">Board of Agriculture, Division of Water Resources Application Number:</div>					
3 LOCATE WELL'S LOCATION WITH AN "X" IN SECTION BOX: <div style="text-align: center;"></div>		4 DEPTH OF COMPLETED WELL... 360.' ft. ELEVATION: Depth(s) Groundwater Encountered 1. .... ft. 2. .... ft. 3. .... ft. WELL'S STATIC WATER LEVEL ... 187'.... ft. below land surface measured on mo/day/yr .. 7/5/88.. Pump test data: Well water was ..... ft. after ..... hours pumping ..... gpm Est. Yield .25..... gpm: Well water was ..... ft. after ..... hours pumping ..... gpm Bore Hole Diameter .9 7/8 in. to ... 360' .... ft., and ..... in. to ..... ft. WELL WATER TO BE USED AS: 5 Public water supply 8 Air conditioning 11 Injection well 1 Domestic      3 Feedlot         6 Oil field water supply 9 Dewatering         12 Other (Specify below) 2 Irrigation     4 Industrial    7 Lawn and garden only 10 Observation well Was a chemical/bacteriological sample submitted to Department? Yes.....No... X.....; If yes, mo/day/yr sample was submitted Water Well Disinfected? Yes X No			
5 TYPE OF BLANK CASING USED: Blank casing diameter ..... 5 in. to ... 360'.... ft., Dia ..... Casing height above land surface ..... 12 ..... in., weight ..... 2.902 ..... lbs./ft. Wall thickness or gauge No. .... 265 TYPE OF SCREEN OR PERFORATION MATERIAL: SCREEN OR PERFORATION OPENINGS ARE: SCREEN-PERFORATED INTERVALS: GRAVEL PACK INTERVALS:					
6 GROUT MATERIAL: Grout Intervals: From ..... 0.. ft. to ..... 20.. ft., From ..... What is the nearest source of possible contamination: Direction from well? East					
FROM TO LITHOLOGIC LOG FROM TO LITHOLOGIC LOG					
See attached log					
7 CONTRACTOR'S OR LANDOWNER'S CERTIFICATION: This water well was completed on (mo/day/year) ..... 6/28/88..... Water Well Contractor's License No. ... 145..... This Water Well Record was completed on (mo/day/yr) ..... 7/12/88..... under the business name of Henkle Drilling & Supply Company, Inc. by signature Bruce J. Richman					
INSTRUCTIONS: Use typewriter or ball point pen. PLEASE PRESS FIRMLY and PRINT clearly. Please fill in blanks, underline or circle the correct answers. Send top three copies to Kansas Department of Health and Environment, Bureau of Water Protection, Topeka, Kansas 66620-7320, Telephone: 913-862-9360. Send one to WATER WELL OWNER and retain one for your records.					

# DRILLERS TEST LOG

**CUSTOMER'S NAME:** Helmerich & Payne Inc.

**DATE:** 1/28/88

**STREET ADDRESS:** 2606 Fleming

TEST # 1 E. LOG Yes

**CITY & STATE:** Garden City, Ks. 67846

**DRILLER** Livingston

QUARTER SW

**SECTION 15**

TOWNSHIP 27

**RANGE** 34

**LOCATION** 15' West of the Old Well.

[illegible]

GARDEN CITY, KS 67846  
3795 West Jones Ave.

**HENKLE-DRILLING & SUPPLY CO., INC.**

316-277-2389

# IRRIGATION HEADQUARTERS

TEST HOLES \* \* \* \* \* IRRIGATION & INDUSTRIAL WELLS \* \* \* \* \* STOCK WELLS