

CORRECTION(S) TO WATER WELL RECORD (WWC-5)

(to rectify lacking or incorrect information)

County: Haskell

Location listed as:

Location changed to:

Section-Township-Range: 25-27-34

25-27 S-34 W

Fraction ($\frac{1}{4}$ $\frac{1}{4}$ $\frac{1}{4}$): NE NE NE

NE NE NE

Other changes: Initial statements: Water Well Owner: Nathan Kells

Changed to: Water Well Owner: Lane Family Rev. Trust and
G.A. & L.O. Robertson Living Trust (see attached letters).

Comments: _____

verification method: See attached letters.


initials: ARL date: 12/20/2006

submitted by: Kansas Geological Survey, Data Resources Library, 1930 Constant Ave., Lawrence, KS 66047-3726
to: Kansas Dept of Health & Environment, Bureau of Water, 1000 SW Jackson, Suite 420, Topeka, KS 66612-1367.

1 LOCATION OF WATER WELL:	Fraction	Section Number	Township Number	Range Number
County: Haskell	NE 1/4 NE 1/4 NE 1/4	25	27	34

Distance and direction from nearest town or city street address of well if located within city?
14 Miles North and 6 Miles West of Sublette

2 WATER WELL OWNER: **Nathan Kells**
 RR #, St. Address, Box #: **A. R. 1, BOX 100**
 City, State, ZIP Code: **Satanta, KS 67870**
 Board of Agriculture, Division of Water Resources
 Application Number: _____

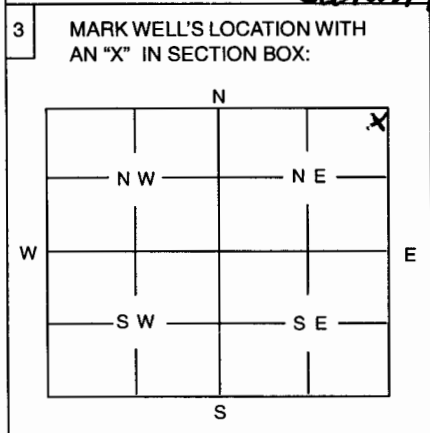

4 DEPTH OF WELL **347** ft
 WELL'S STATIC WATER LEVEL **305** ft.
 WELL WAS USED AS:
 1 Domestic 5 Public Water Supply 9 Dewatering
 2 Irrigation 6 Oil Field Water Supply 10 Monitoring Well
 3 Feedlot 7 Domestic (Lawn & Garden) 11 Injection Well
 4 Industrial 8 Air Conditioning 12 Other

Was a chemical / bacteriological sample submitted to Department? Yes No **X**.....
 If yes, mo/day/yr sample was submitted

Water Well Disinfected: Yes **X**..... No

5 TYPE OF BLANK CASING USED:
 1 Steel 3 RMP (SR) 5 Wrought 7 Fiberglass 9 Other (Specify below)
 2 PVC 4 ABS 6 Asbestos-Cement 8 Concrete Tile

Blank casing diameter **16** in. Was casing pulled? Yes No **X**..... If yes, how much

Casing height above or below land surface **36** in.

6 GROUT PLUG MATERIAL: 1 Neat cement 2 Cement grout 3 Bentonite 4 Other

Grout Plug Intervals: From ft. to ft., From ft. to ft., From to ft.

What is the nearest source of possible contamination:
 1 Septic tank 6 Seepage pit 11 Fuel storage 16 Other (specify below)
 2 Sewer lines 7 Pit privy 12 Fertilizer storage

3 Watertight sewer lines 8 Sewage lagoon 13 Insecticide storage

4 Lateral lines 9 Feedyard 14 Abandoned water well

5 Cess Pool 10 Livestock pens 15 Oil well/Gas well

Direction from well? **West** How many feet? **1500**

FROM	TO	PLUGGING MATERIALS
347	305	Chlorinated Sand
305	6	Clay/Subsoil
6	3	Bentonite
3	-	Cut off casing & Backfill

7 CONTRACTOR'S OR LANDOWNER'S CERTIFICATION: This water well was plugged under my jurisdiction and was completed on (mo/day/year) **8-29-00** and this record is true to the best of my knowledge and belief. Kansas Water Well Contractor's License No. _____ This Water Well Record was completed on (mo/day/year) **8-29-00** under the business name of **Southwest Windmill** by (signature) **David Ems**

INSTRUCTIONS: Use typewriter or ball point pen. Please press firmly and print clearly. Please fill in blanks, underline or circle the correct answers. Send top three copies to Kansas Department of Health and Environment, Bureau of Water, Topeka, Kansas 66620-0001. Telephone: 785/296-3565. Send one to Water Well Owner and retain one for your records.

12-1-06

KDHE
Topeka, KS

To whom it may concern,

In response to a letter dated Nov 22, 2006 to Robert and Vera Lane regarding the status of their water well.

I, Nathan Kells had the well in question plugged in 2000. In a search of the database using the legal description, it brought up that I was the owner. I was and still am the tenant of said property, but not the owner.

We would like to request a name change to reflect the actual ownership of said property, NE of 25-27-34, Haskell Co. Kansas

Please change ownership to:

Lane Family Rev. Trust
Contact: Robert and Vera Lane 316-778-1936
Box 252
Benton, KS 67017

And

G.A. & L.O. Robertson Living Trust
Contact: George Robertson 248-851-7833
1893 Golf Ridge Drive
Bloomfield Hills, MI 48302

Sincerely,



Nathan Kells

620-275-1182

RECEIVED

DEC 04 2006

BUREAU OF WATER