

WATER WELL RECORD Form WWC-5


Original Record Correction Change in Well Use

Division of Water Resources App. No.

Well ID

1 LOCATION OF WATER WELL: County: Haskell	Fraction SW ¼ SW ¼ SW ¼ SE ¼	Section Number 31	Township Number T 27 S	Range Number R 34 <input type="checkbox"/> E <input checked="" type="checkbox"/> W
---	---------------------------------	----------------------	---------------------------	---

2 WELL OWNER: Last Name: Taton First: Gary Business: Address: 621 Rd. CC Address: City: Satanta State: KS ZIP: 67870	Street or Rural Address where well is located (if unknown, distance and direction from nearest town or intersection): If at owner's address, check here: <input type="checkbox"/> County Rd CC & 70 Rd 1 1/2 Miles West
---	---

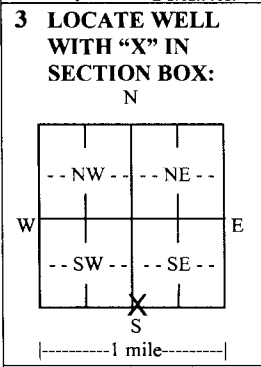

4 DEPTH OF COMPLETED WELL: 540 ft.
Depth(s) Groundwater Encountered: 1) 320 ft.
2) ft. 3) ft., or 4) Dry Well
WELL'S STATIC WATER LEVEL: 320 ft.
 below land surface, measured on (mo-day-yr) 04/19/2018
 above land surface, measured on (mo-day-yr)

Pump test data: Well water was ft.
after hours pumping gpm
Well water was ft.
after hours pumping gpm
Estimated Yield: 30 gpm
Bore Hole Diameter: 10 in. to 540 ft. and
..... in. to ft.

5 Latitude: 37.649642 (decimal degrees)
Longitude: 101.080957 (decimal degrees)
Datum: WGS 84 NAD 83 NAD 27
Source for Latitude/Longitude:
 GPS (unit make/model:)
(WAAS enabled? Yes No)
 Land Survey Topographic Map
 Online Mapper:

6 Elevation: 3081 ft. Ground Level TOC
Source: Land Survey GPS Topographic Map
 Other KOLAR

7 WELL WATER TO BE USED AS:

1. Domestic: <input checked="" type="checkbox"/> Household <input type="checkbox"/> Lawn & Garden <input type="checkbox"/> Livestock	5. <input type="checkbox"/> Public Water Supply: well ID	10. <input type="checkbox"/> Oil Field Water Supply: lease
2. <input type="checkbox"/> Irrigation	6. <input type="checkbox"/> Dewatering: how many wells?	11. Test Hole: well ID
3. <input type="checkbox"/> Feedlot	7. <input type="checkbox"/> Aquifer Recharge: well ID	<input type="checkbox"/> Cased <input type="checkbox"/> Uncased <input type="checkbox"/> Geotechnical
4. <input type="checkbox"/> Industrial	8. <input type="checkbox"/> Monitoring: well ID	12. Geothermal: how many bores?
	9. Environmental Remediation: well ID	a) Closed Loop <input type="checkbox"/> Horizontal <input type="checkbox"/> Vertical
	<input type="checkbox"/> Air Sparge <input type="checkbox"/> Soil Vapor Extraction	b) Open Loop <input type="checkbox"/> Surface Discharge <input type="checkbox"/> Inj. of Water
	<input type="checkbox"/> Recovery <input type="checkbox"/> Injection	13. <input type="checkbox"/> Other (specify):

Was a chemical/bacteriological sample submitted to KDHE? Yes No If yes, date sample was submitted:

Water well disinfected? Yes No

8 TYPE OF CASING USED: Steel PVC Other CASING JOINTS: Glued Clamped Welded Threaded
Casing diameter 5 in. to 540 ft., Diameter in. to ft., Diameter in. to ft.
Casing height above land surface 18 in. Weight lbs./ft. Wall thickness or gauge No. SDR 17

TYPE OF SCREEN OR PERFORATION MATERIAL:
 Steel Stainless Steel Fiberglass PVC Other (Specify) Certalok
 Brass Galvanized Steel Concrete tile None used (open hole)

SCREEN OR PERFORATION OPENINGS ARE:
 Continuous Slot Mill Slot Gauze Wrapped Torch Cut Drilled Holes Other (Specify)
 Louvered Shutter Key Punched Wire Wrapped Saw Cut None (Open Hole)

SCREEN-PERFORATED INTERVALS: From 400 ft. to 540 ft., From ft. to ft., From ft. to ft.
GRAVEL PACK INTERVALS: From 45 ft. to 540 ft., From ft. to ft., From ft. to ft.

9 GROUT MATERIAL: Neat cement Cement grout Bentonite Other

GROUT INTERVALS: From 0 ft. to 45 ft., From ft. to ft., From ft. to ft.

Nearest source of possible contamination:
 Septic Tank Lateral Lines Pit Privy Livestock Pens Insecticide Storage
 Sewer Lines Cess Pool Sewage Lagoon Fuel Storage Abandoned Water Well
 Watertight Sewer Lines Seepage Pit Feedyard Fertilizer Storage Oil Well/Gas Well
 Other (Specify)

Direction from well? East Distance from well? 150 ft.

10 FROM	TO	LITHOLOGIC LOG	FROM	TO	LITHO. LOG (cont.) or PLUGGING INTERVALS
Attached	Attached	Attached			
Notes:					

11 CONTRACTOR'S OR LANDOWNER'S CERTIFICATION: This water well was constructed, reconstructed, or plugged under my jurisdiction and was completed on (mo-day-year) 04/19/2018 and this record is true to the best of my knowledge and belief. Kansas Water Well Contractor's License No. 846 This Water Well Record was completed on (mo-day-year) 04/23/2018 under the business name of Nash Water Well Service, LLC

Haskell

SW-SW-SW-SE

31-27-34W

Form	WWC5
Contractor	Nash Water Well Service, LLC
Well Owner	Gary Taton
Doc ID	1406763

Litholgy

0	14	TOP SOIL, BROWN CLAY WITH FINE SAND
14	21	TAN CLAY, CALICHE, FINE SAND
21	65	TAN CLAY/FINE SAND
65	108	TIGHT FINE SAND WITH TAN CLAY
108	120	FINE COARSE SAND, SMALL/MEDIUM GRAVEL WITH TAN CLAY STREAKS
120	190	FINE COARSE SAND, WITH STREAKS OF SMALL TO MEDIUM GRAVEL
190	200	FINE SAND WITH TAN CLAY
200	207	FINE COARSE SAND, WITH TAN/RED/BROWN CLAY GRAVEL
207	236	TAN CLAY STREAKS
236	240	FINE MEDIUM SAND
240	275	TAN CLAY WITH FINE SAND STREAKS
275	297	FINE MEDIUM SAND WITH TAN CLAY LAYERS
297	320	BLUE/GRAY/TAN/BROWN/REDISH CLAY WITH FINE SAND STREAKS
320	350	TAN/BROWN CLAY WITH FINE COARSE SAND STREAKS

Haskell

SW SW SW SE

31-27-34W

Form	WWC5
Contractor	Nash Water Well Service, LLC
Well Owner	Gary Taton
Doc ID	1406763

Litholgy

350	403	FINE COARSE SAND
403	405	ROCK WHITE, HARD
405	430	FINE COARSE SAND
430	445	FINE SAND
445	451	TAN CLAY
451	490	FINE SAND, WITH TAN CLAY STREAKS
490	538	FINE MEDIUM SAND
538	547	YELLOW/ORANGE/BROWN CLAY WITH FINE SAND STREAKS
547	560	YELLOW, BROWN CLAY