


1 LOCATION OF WATER WELL: Fraction NW 1/4 NE 1/4 Section Number 26 Township Number T 27S S Range Number R 35W **EW**

Distance and direction from nearest town or city street address of well if located within city?  
 10 MILES NORTHEAST HICKOK, KS

2 WATER WELL OWNER: OXY USA, INC #1 JONES G  
 RR#, St. Address, Box #: P.O. BOX 26100 Board of Agriculture, Division of Water Resources  
 City, State, ZIP Code: OKLAHOMA CITY, OK 73126-0100 Application Number: Oxy permitted

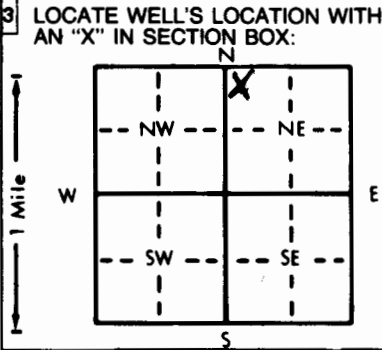

4 DEPTH OF COMPLETED WELL: 340 ft. ELEVATION: .....  
 Depth(s) Groundwater Encountered 1. 185 ft. 2. .... ft. 3. .... ft.  
 WELL'S STATIC WATER LEVEL .185 ft. below land surface measured on mo/day/yr 11-8-93  
 Pump test data: Well water was .200 ft. after .1 hours pumping .100 gpm  
 Est. Yield .100 gpm: Well water was ..... ft. after ..... hours pumping ..... gpm  
 Bore Hole Diameter .11 in. to .340 ft., and ..... in. to ..... ft.  
 WELL WATER TO BE USED AS:  
 5 Public water supply 8 Air conditioning 11 Injection well  
 1 Domestic 3 Feedlot **6** Oil field water supply 9 Dewatering 12 Other (Specify below)  
 2 Irrigation 4 Industrial 7 Lawn and garden only 10 Monitoring well  
 Was a chemical/bacteriological sample submitted to Department? Yes.....No **x**.....; If yes, mo/day/yr sample was submitted  
 Water Well Disinfected? Yes **x** No

5 TYPE OF BLANK CASING USED:  
 1 Steel 3 RMP (SR) 5 Wrought iron 8 Concrete tile CASING JOINTS: Glued **x** Clamped .....  
**2** PVC 4 ABS 6 Asbestos-Cement 9 Other (specify below) Welded .....  
 7 Fiberglass ..... Threaded .....  
 Blank casing diameter .6 in. to .340 ft., Dia ..... in. to ..... ft., Dia ..... in. to ..... ft.  
 Casing height above land surface .24 in., weight 2.902 lbs./ft. Wall thickness or gauge No. .280 SDR .21  
 TYPE OF SCREEN OR PERFORATION MATERIAL:  
 1 Steel 3 Stainless steel 5 Fiberglass **7** PVC 10 Asbestos-cement  
 2 Brass 4 Galvanized steel 6 Concrete tile 8 RMP (SR) 11 Other (specify) .....  
 9 ABS 12 None used (open hole)  
 SCREEN OR PERFORATION OPENINGS ARE:  
 5 Gauzed wrapped **8** Saw cut 11 None (open hole)  
 1 Continuous slot 3 Mill slot 6 Wire wrapped 9 Drilled holes  
 2 Louvered shutter 4 Key punched 7 Torch cut 10 Other (specify) .....  
 SCREEN-PERFORATED INTERVALS: From .240 ft. to .340 ft., From ..... ft. to ..... ft.  
 From ..... ft. to ..... ft., From ..... ft. to ..... ft.  
 GRAVEL PACK INTERVALS: From .240 ft. to .340 ft., From ..... ft. to ..... ft.  
 From ..... ft. to ..... ft., From ..... ft. to ..... ft.

6 GROUT MATERIAL: **1** Neat cement 2 Cement grout 3 Bentonite **4** Other ..... HOLE PLUG .....  
 Grout Intervals: From .1 ft. to .20 ft., From ..... ft. to ..... ft., From ..... ft. to ..... ft.  
 What is the nearest source of possible contamination:  
 1 Septic tank 4 Lateral lines 7 Pit privy 10 Livestock pens 14 Abandoned water well  
 2 Sewer lines 5 Cess pool 8 Sewage lagoon 11 Fuel storage **15** Oil well/Gas well  
 3 Watertight sewer lines 6 Seepage pit 9 Feedyard 12 Fertilizer storage 16 Other (specify below)  
 13 Insecticide storage  
 Direction from well? *North* How many feet? *100*

FROM	TO	LITHOLOGIC LOG	FROM	TO	PLUGGING INTERVALS
0	10	TOPSOIL			
10	25	SANDY CLAY			
25	200	FINE TO COARSE SAND			
200	240	COARSE SAND & STREAKS OF CLAY			
240	320	COARSE SAND			
320	340	COARSE SAND & BLUE CLAY STREAKS			

7 CONTRACTOR'S OR LANDOWNER'S CERTIFICATION: This water well was **(1)** constructed, (2) reconstructed, or (3) plugged under my jurisdiction and was completed on (mo/day/year) 11-8-93 and this record is true to the best of my knowledge and belief. Kansas Water Well Contractor's License No. KWWCL-430 This Water Well Record was completed on (mo/day/yr) 11-8-93 under the business name of HOWARD DRIG. CO. BOX 806 BEAVER, OK 73932 by signature *[Signature]*

INSTRUCTIONS: Use typewriter or ball point pen. PLEASE PRESS FIRMLY and PRINT clearly. Please fill in blanks, underline or circle the correct answers. Send top three copies to Kansas Department of Health and Environment, Bureau of Water, Topeka, Kansas 66620-0001. Telephone: 913-296-5545. Send one to WATER WELL OWNER and retain one for your records.