


1 LOCATION OF WATER WELL: County: Grant Fraction: $\frac{1}{4}$ W $\frac{1}{2}$ $\frac{1}{4}$ NE $\frac{1}{4}$ Section Number: 26 Township Number: T 27 S Range Number: R 35 E/W

Distance and direction from nearest town or city street address of well if located within city?

9 1/2 miles NE of Hickok, KS.

2 WATER WELL OWNER: OXY USA, Inc. RR#, St. Address, Box #: Box 26100 City, State, ZIP Code: Oklahoma City, OK 73126 Board of Agriculture, Division of Water Resources Application Number: OXY permitted

3 LOCATE WELL'S LOCATION WITH AN "X" IN SECTION BOX:

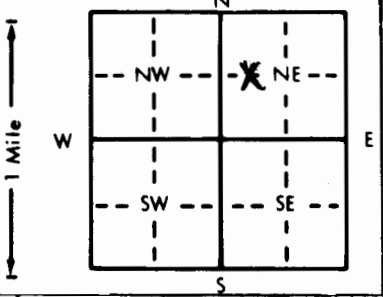

4 DEPTH OF COMPLETED WELL: 340 ft. ELEVATION: _____ ft.
 Depth(s) Groundwater Encountered: 1. 210 ft. 2. _____ ft. 3. _____ ft.
 WELL'S STATIC WATER LEVEL: 210 ft. below land surface measured on mo/day/yr 07-03-90
 Pump test data: Well water was 220 ft. after 1 hours pumping 100 gpm
 Est. Yield 100 gpm: Well water was _____ ft. after _____ hours pumping _____ gpm
 Bore Hole Diameter: 11 in. to 340 ft., and _____ in. to _____ ft.
 WELL WATER TO BE USED AS:
 5 Public water supply 8 Air conditioning 11 Injection well
 1 Domestic 3 Feedlot 6 Oil field water supply 9 Dewatering 12 Other (Specify below)
 2 Irrigation 4 Industrial 7 Lawn and garden only 10 Monitoring well
 Was a chemical/bacteriological sample submitted to Department? Yes _____ No X; If yes, mo/day/yr sample was submitted _____
 Water Well Disinfected? Yes X No _____

5 TYPE OF BLANK CASING USED:
 1 Steel 3 RMP (SR) 5 Wrought iron 8 Concrete tile CASING JOINTS: Glued X Clamped _____
2 PVC 4 ABS 6 Asbestos-Cement 9 Other (specify below) Welded _____
 7 Fiberglass Threaded _____

Blank casing diameter: 6 in. to 340 ft., Dia. _____ in. to _____ ft., Dia. _____ in. to _____ ft.
 Casing height above land surface: 24 in., weight _____ lbs./ft. Wall thickness or gauge No. 032

TYPE OF SCREEN OR PERFORATION MATERIAL:
 1 Steel 3 Stainless steel 5 Fiberglass 7 PVC 10 Asbestos-cement
 2 Brass 4 Galvanized steel 6 Concrete tile 8 RMP (SR) 11 Other (specify) _____
 9 ABS 12 None used (open hole)

SCREEN OR PERFORATION OPENINGS ARE:
 1 Continuous slot 3 Mill slot 5 Gauzed wrapped 8 Saw cut 11 None (open hole)
 2 Louvered shutter 4 Key punched 6 Wire wrapped 9 Drilled holes
 7 Torch cut 10 Other (specify) _____

SCREEN-PERFORATED INTERVALS: From 200 ft. to 340 ft., From _____ ft. to _____ ft.
 From _____ ft. to _____ ft., From _____ ft. to _____ ft.
 GRAVEL PACK INTERVALS: From 160 ft. to 340 ft., From _____ ft. to _____ ft.
 From _____ ft. to _____ ft., From _____ ft. to _____ ft.

6 GROUT MATERIAL: 1 Neat cement 2 Cement grout 3 Bentonite 4 Other dirt
 Grout Intervals: From 1 ft. to 20 ft., From _____ ft. to _____ ft., From _____ ft. to _____ ft.

What is the nearest source of possible contamination:
 1 Septic tank 4 Lateral lines 7 Pit privy 10 Livestock pens 14 Abandoned water well
 2 Sewer lines 5 Cess pool 8 Sewage lagoon 11 Fuel storage 15 Oil well/Gas well
 3 Watertight sewer lines 6 Seepage pit 9 Feedyard 12 Fertilizer storage 16 Other (specify below)
 13 Insecticide storage

Direction from well? Southeast How many feet? 150

FROM	TO	LITHOLOGIC LOG	FROM	TO	PLUGGING INTERVALS
0	30	Clay			
30	150	Sand			
150	225	Sandy Clay			
225	325	Sand			
325	340	Clay			

7 CONTRACTOR'S OR LANDOWNER'S CERTIFICATION: This water well was (1) constructed, (2) reconstructed, or (3) plugged under my jurisdiction and was completed on (mo/day/year) 07-03-90 and this record is true to the best of my knowledge and belief. Kansas Water Well Contractor's License No. KWCL-430 This Water Well Record was completed on (mo/day/yr) 07-03-90 under the business name of Howard Drlg. Co. Box 806 Beaver, OK 73932 by (signature) *Howard Drlg. Co.*

INSTRUCTIONS: Use typewriter or ball point pen. PLEASE PRESS FIRMLY and PRINT clearly. Please fill in blanks, underline or circle the correct answers. Send top three copies to Kansas Department of Health and Environment, Bureau of Water, Topeka, Kansas 66620-7320. Telephone: 913-296-5545. Send one to WATER WELL OWNER and retain one for your records.