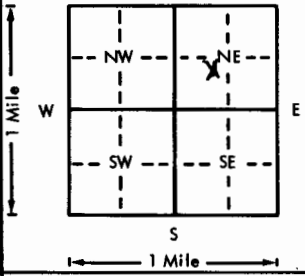


USE TYPEWRITER OR BALL
POINT PEN-PRESS FIRMLY,
PRINT CLEARLY.

WATER WELL RECORD
KSA 82a-1201-1215

Kansas Department of Health and
Environment-Division of Environment
(Water well Contractors)
Topeka, Kansas 66620

1. Location of well:		County Grant	Fraction NE 1/4 SW 1/4 NE 1/4	Section number 5	Township number T 27 S	Range number R 36 E/W
2. Distance and direction from nearest town or city: 7 north, 11 east 3 1/2 north 1/2 east of Ulysses, Ks.			3. Owner of well: Charles Dew R.R. or street: RFD 1 City, state, zip code: Ulysses, Kans. 67880			
4. Locate with "X" in section below: <div style="text-align: center;">N 1 Mile W  E S 1 Mile</div>			Sketch map:		6. Bore hole dia. 27 in. Completion date 10-1-75 Well depth 400.7 ft.	
5. Type and color of material			From		To	
			Surface		0 2	
			Sandy clay		2 30	
			Fine sand		30 93	
			Coarse sand and gravel		93 220	
			Medium sand		220 260	
			Fine to medium sand		260 290	
			Medium to coarse sand		290 340	
			Clay		340 350	
			Fine to medium sand w/clay breakers		350 400	
7. <input type="checkbox"/> Cable tool <input checked="" type="checkbox"/> Rotary <input type="checkbox"/> Driven <input type="checkbox"/> Dug <input type="checkbox"/> Hollow rod <input type="checkbox"/> Jetted <input type="checkbox"/> Bored <input type="checkbox"/> Reverse rotary			8. Use: <input type="checkbox"/> Domestic <input type="checkbox"/> Public supply <input type="checkbox"/> Industry <input checked="" type="checkbox"/> Irrigation <input type="checkbox"/> Air conditioning <input type="checkbox"/> Stock <input type="checkbox"/> Lawn <input type="checkbox"/> Oil field water <input type="checkbox"/> Other			
9. Casing: Material steel Height: Above or below Threaded <input type="checkbox"/> Welded <input checked="" type="checkbox"/> Surface 12 in. RMP <input type="checkbox"/> PVC <input type="checkbox"/> Weight 36.8 lbs./ft. Dia. 16 in. to 198.4 ft. depth Wall thickness inches or Dia. <input type="checkbox"/> in. to <input type="checkbox"/> ft. depth gage No. 219			10. Screen: Manufacturer's name Lakewood Type steel Dia. 16" Slot/gauze 3/16 Length 202.3 ft. Set between 198.4 ft. and 400.7 ft. ft. and <input type="checkbox"/> ft. Gravel pack? <input checked="" type="checkbox"/> Size range of material 1/2 x 5/8"			
11. Static water level: <input type="checkbox"/> mo./day/yr. 165 ft. below land surface Date 9-29-75			12. Pumping level below land surfaces: 193 ft. after 30.7 hrs. pumping 1436 g.p.m. <input type="checkbox"/> ft. after <input type="checkbox"/> hrs. pumping <input type="checkbox"/> g.p.m. Estimated maximum yield 2000 g.p.m.			
13. Water sample submitted: <input type="checkbox"/> mo./day/yr. Yes <input checked="" type="checkbox"/> No <input type="checkbox"/> Date <input type="checkbox"/>			14. Well head completion: NA <input type="checkbox"/> Pitless adapter 12 inches above grade			
15. Well grouted? NA yes With: <input type="checkbox"/> Neat cement <input checked="" type="checkbox"/> Bentonite <input type="checkbox"/> Concrete Depth: From 0 ft. to 12 ft.			16. Nearest source of possible contamination: ft. 5000 Direction NW Type home Well disinfected upon completion? <input type="checkbox"/> Yes <input type="checkbox"/> No			
17. Pump: <input checked="" type="checkbox"/> Not installed Manufacturer's name <input type="checkbox"/> Model number <input type="checkbox"/> HP <input type="checkbox"/> Volts <input type="checkbox"/> Length of drop pipe <input type="checkbox"/> ft. capacity <input type="checkbox"/> g.p.m. Type: <input type="checkbox"/> Submersible <input type="checkbox"/> Turbine <input type="checkbox"/> Jet <input type="checkbox"/> Reciprocating <input type="checkbox"/> Centrifugal <input type="checkbox"/> Other			20. Water well contractor's certification: This well was drilled under my jurisdiction and this report is true to the best of my knowledge and belief. Houck Bros. Drlg. Co. 164 Business name Box 487, Ulysses, Ks. License No. Address 11-21-75 Signed M. Beard Date <input type="checkbox"/> Authorized representative			
18. Elevation:		19. Remarks:				
Topography: <input type="checkbox"/> Hill <input checked="" type="checkbox"/> Slope <input type="checkbox"/> Upland <input type="checkbox"/> Valley		(Use a second sheet if needed)				

27 360 - 5 NE SW NE
T R Sec 1/4 1/4 1/4

Forward the white, blue and pink copies to the Department of Health and Environment

Form WWC-5