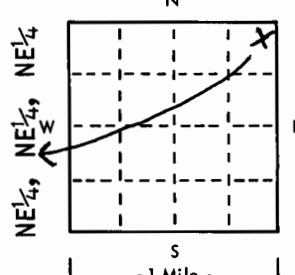
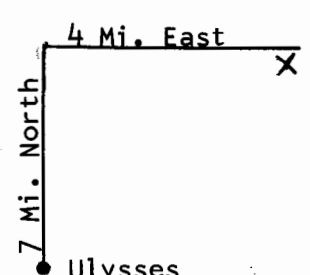


USE TYPEWRITER OR BALL
POINT PEN-PRESS FIRMLY.
PRINT CLEARLY.

WATER WELL RECORD
KSA 82a-1201-1215

T R EW sec 1/4 1/4 1/4 No.

Kansas State Dept. Of Health
(Water Well Contractors)
Forbes-Bldg. 740
Topeka, Kansas 66620

1. Location of well:	County Grant	Township name	Fraction NE$\frac{1}{4}$, NE$\frac{1}{4}$, NE$\frac{1}{4}$	Section number 30	Town number T27W	Range number R36W
Distance and direction from nearest town or city: 7 mi. north & 4 mi. East of Ulysses on south side of road				3. Owner of well: Edward Isaac Address: Route 1 Ulysses, Kansas 67880		
Locate with "X" in section below: 				Sketch map: 		
2. Type and color of material				From	To	
Surface & Fine Sand				0	15	
Brown Clay				15	120	
Sand				120	135	
Sand & Brown Clay				135	150	
Brown Clay				150	180	
Sand				180	195	
Brown Sandy Clay				195	210	
Brown XXXX Clay				210	220	
Brown Clay & Sand				220	240	
75% Coarse Sand & Brown Clay Strips				240	255	
Coarse Sand				255	281	
Sandy Clay & Gyp - Med. tight				281	300	
Brown Clay				300	315	
Brown Sandy Clay				315	375	
Blue & Brown Shale - Hard				375	390	
Blue Shale - Hard (use a second sheet if needed)				390	405	
16. Remarks: elevation				17. Water well contractor's certification:		
Topography: <input checked="" type="checkbox"/> Hill <input checked="" type="checkbox"/> Slope <input type="checkbox"/> Upland <input type="checkbox"/> Valley				This well was drilled under my jurisdiction and this report is true to the best of my knowledge and belief. K. I. Drilling Co., Inc. 263 Business name License No. Address Box 669, Ulysses, Kan. Signed M. J. Baker Date 1-22-76 Authorized representative		

Forward the white, blue and pink copies to the Kansas State Dept. Of Health.

Form WWC-5