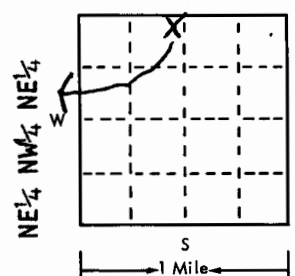
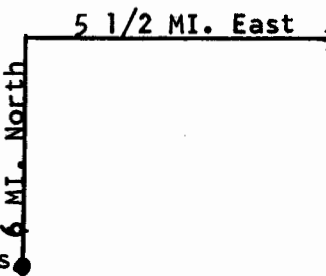


USE TYPEWRITER OR BALL
POINT PEN-PRESS FIRMLY,
PRINT CLEARLY.

WATER WELL RECORD
KSA 82a-1201-1215

T R EW sec 1/4 1/4 1/4 No.

Kansas State Dept. Of Health
(Water Well Contractors)
Forbes-Bldg. 740
Topeka, Kansas 66620

1 Location of well:	County Grant	Township name	Fraction NE$\frac{1}{4}$ NW$\frac{1}{4}$ NE$\frac{1}{4}$	Section number 32	Town number T27S	Range number R36W
Distance and direction from nearest town or city: 6 mi. north & 5 1/2 mi. East of Ulysses Street address of well location if in city:				3 Owner of well: Carl Moyer Address: Route 1 Ulysses, Kansas 67880		
Locate with "X" in section below: 				Sketch map: 		
2 Type and color of material				From	To	4 Well depth: 430 ft. Date of completion _____ Well diameter 26 in.
Surface, Fine Sand to Medium Sand				0	45	5 <input type="checkbox"/> Cable tool <input type="checkbox"/> Rotary <input type="checkbox"/> Driven <input type="checkbox"/> Dug <input type="checkbox"/> Hollow rod <input type="checkbox"/> Jetted <input type="checkbox"/> Bored <input checked="" type="checkbox"/> Reverse rotary
Brown Clay				45	165	6 Use: <input type="checkbox"/> Domestic <input type="checkbox"/> Public supply <input type="checkbox"/> Industry <input checked="" type="checkbox"/> Irrigation <input type="checkbox"/> Air conditioning <input type="checkbox"/> Commercial <input type="checkbox"/> Test well <input type="checkbox"/>
Sand				165	180	7 Casing: Material Steel Height: above/below Threaded <input type="checkbox"/> Welded <input checked="" type="checkbox"/> Surface 12 in. Diam. 16 in. to 430 ft. depth! Drive shoe? <input type="checkbox"/> Yes <input checked="" type="checkbox"/> No _____ in. to _____ ft. depth!
Sand & Brown Clay - 50%				180	195	8 Screen: Manufacturer Johnson Type Galvanized Dia. 16 in. Slot/groove 100X100 Length 50 ft. Set between 260 ft. and 300 ft. 360 & 370 Fittings: See remarks Gravel pack <input checked="" type="checkbox"/> Yes <input type="checkbox"/> No Size range of material 1/2 down
Brown Clay				195	240	9 Static water level: 210 ft. below land surface Date 4-22-76 3-76
Sandrock & Brpwn Clay - 60%				240	255	10 Pumping level below land surfaces: 260 ft. after 2 hrs. pumping 1000 g.p.m. _____ ft. after _____ hrs. pumping _____ g.p.m. Estimated maximum yield 1000 g.p.m.
Sand & Brown Clay - 40 %				255	270	11 Water sample submitted: <input type="checkbox"/> Yes <input checked="" type="checkbox"/> No Date _____
Sand (Good)				270	305	12 Well head completion: 12 in. <input type="checkbox"/> Pitless adapter <input checked="" type="checkbox"/> Inches above grade
Brown Clay				305	330	13 Well grouted? <input checked="" type="checkbox"/> Yes <input type="checkbox"/> No <input checked="" type="checkbox"/> Neat cement <input checked="" type="checkbox"/> Bentonite <input type="checkbox"/> Depth: From 0 ft. to 10 ft.
Fine to Med. Sand & Brown Clay - 50%				330	345	14 Nearest source of possible contamination: ft. _____ Direction _____ Type _____ Well disinfected upon completion? <input type="checkbox"/> Yes <input checked="" type="checkbox"/> No
Brown Clay				345	350	15 Pump: <input type="checkbox"/> Not installed Manufacturer's name EMMEXX Goulds Model number 12J HP 200 Volts _____ Length of drop pipe 400 ft. capacity 1000 g.m.p. Type: <input type="checkbox"/> Submersible <input checked="" type="checkbox"/> Turbine <input type="checkbox"/> Jet <input type="checkbox"/> Reciprocating <input type="checkbox"/> Centrifugal <input type="checkbox"/> Other
Dakota				350	355	17 Water well contractor's certification: This well was drilled under my jurisdiction and this report is true to the best of my knowledge and belief. K. I. Drilling Co., Inc. 263 Business name _____ License No. _____ Address Box 669, Ulysses, Kn. 67880 Signed M. Joyce Bunker Date 4-20-76 Authorized representative
Brown Clay				355	360	
Sandstone, Dakota & Brown Clay - 75%				360	380	
Gray Clay & Blue Shale				380	420	
Gray Clay & Blue Sahle - a little Dakota				420	430	
Blue Shale				430	465	
(use a second sheet if needed)						
16 Remarks: elevation Topography: <input type="checkbox"/> Hill <input type="checkbox"/> Slope <input type="checkbox"/> Upland <input type="checkbox"/> Valley Drilling Sub-contracted to: Minter-Wilson Drilling Co. License Garden City, Kan. 67846 #208 * Lakewood Perf. - Slot - 125 X 66 Set Between 240' & 260', 300' & 360', 370' & 430'						