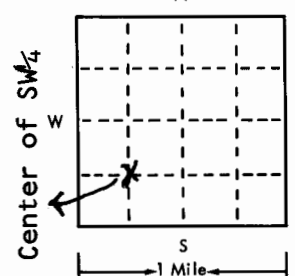
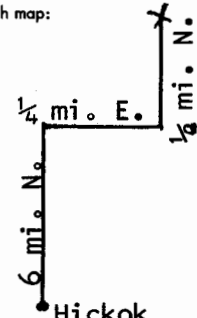


USE TYPEWRITER OR BALL  
POINT PEN-PRESS FIRMLY,  
PRINT CLEARLY.

WATER WELL RECORD  
KSA 82a-1201-1215

T R EW sec 1/4 1/4 1/4 No.

Kansas State Dept. Of Health  
(Water Well Contractors)  
Forbes-Bldg. 740  
Topeka, Kansas 66620

1 Location of well:	County <b>Grant</b>	Township name	Fraction <b>C - SW<math>\frac{1}{4}</math></b>	Section number <b>35</b>	Town number <b>T27S</b>	Range number <b>R36W</b>
Distance and direction from nearest town or city: <b>6 mi. N., <math>\frac{1}{4}</math> mi. E., <math>\frac{1}{4}</math> Mi. N. of Hickok</b> Street address of well location in city:				3 Owner of well: <b>Howard Lighty</b> Address: <b>R.F.D. Ulysses, Kansas 67880</b>		
Locate with "X" in section below: 				Sketch map: 		
2 Type and color of material				From	To	
Surface to Fine Sand				0	15	
Brown Clay & Gyp				15	75	
Medium Sand				75	180	
Brown Clay				180	210	
Medium Sand				210	225	
Brown Clay				225	255	
Medium Sand				255	375	
Brown Clay				375	390	
Coarse Sand				390	420	
Coarse Sand (Cemented)				420	435	
Brown Clay & Gyp				435	465	
Brown Clay with Sand Strips 50%				465	480	
Medium Sand				480	495	
Brown Clay				495	500	
(use a second sheet if needed)						
16- Remarks: elevation				Drilling Sub-contracted to: <b>Minter-Wilson Drilling Co. License #208</b> <b>Garden City, Kansas</b> * Lakewood Perf. - Slot - .125 X 66 Set between 300' & 400', 420' & 475', 495' & 500'		
Topography: <input type="checkbox"/> Hill <input checked="" type="checkbox"/> Slope <input type="checkbox"/> Upland <input type="checkbox"/> Valley				17 Water well contractor's certification: This well was drilled under my jurisdiction and this report is true to the best of my knowledge and belief. <b>K. I. Drilling Co., Inc. 263</b> Business name License No. Address <b>Box 669, Ulysses, Kan.</b> Signed <b>Bob Jackson</b> Date <b>8-26-75</b> Authorized representative		

Forward the white, blue and pink copies to the Kansas State Dept. Of Health.

Form WWC-5