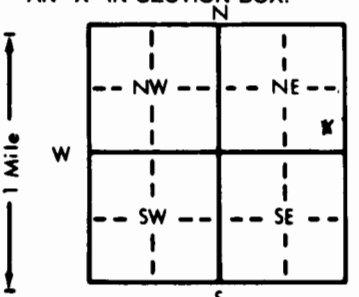


1 LOCATION OF WATER WELL:		Fraction	Section Number	Township Number	Range Number
County: Grant		SE 1/4 SE 1/4 NE 1/4	35	T 27 S	R 36W EW
Distance and direction from nearest town or city street address of well if located within city? Hickok, Kansas - 6 5/8 miles North West into location					
2 WATER WELL OWNER: Richard Long		Cheyenne Drilling/Petroleum Inc.			
RR#, St. Address, Box # :		Board of Agriculture, Division of Water Resources			
City, State, ZIP Code : Garden City, Kansas		Application Number: T 89-035			
3 LOCATE WELL'S LOCATION WITH AN "X" IN SECTION BOX:		4 DEPTH OF COMPLETED WELL: 400' ft. ELEVATION:			
		Depth(s) Groundwater Encountered 1. ft. 2. ft. 3. ft.			
		WELL'S STATIC WATER LEVEL 221' ft. below land surface measured on mo/day/yr 01/26/89			
		Pump test data: Well water was ft. after hours pumping gpm			
		Est. Yield gpm: Well water was ft. after hours pumping gpm			
		Bore Hole Diameter 9 7/8" to 400' ft. and in. to ft.			
		WELL WATER TO BE USED AS: 5 Public water supply 8 Air conditioning 11 Injection well			
		1 Domestic 3 Feedlot 6 Oil field water supply 9 Dewatering 12 Other (Specify below)			
		2 Irrigation 4 Industrial 7 Lawn and garden only 10 Observation well			
		Was a chemical/bacteriological sample submitted to Department? Yes No X If yes, mo/day/yr sample was submitted			
		Water Well Disinfected? Yes X No			
5 TYPE OF BLANK CASING USED:		CASING JOINTS: Glued Clamped			
1 Steel 3 RMP (SR) 6 Asbestos-Cement 9 Other (specify below) Welded		Threaded			
2 PVC 4 ABS 7 Fiberglass					
Blank casing diameter 5 5/8 in. to 280' ft. Dia in. to ft. Dia in. to ft.					
Casing height above land surface 28 in. weight 2.93 lbs./ft. Wall thickness or gauge No. 265					
TYPE OF SCREEN OR PERFORATION MATERIAL:		7 PVC 10 Asbestos-cement			
1 Steel 3 Stainless steel 5 Fiberglass 8 RMP (SR) 11 Other (specify)		12 None used (open hole)			
2 Brass 4 Galvanized steel 6 Concrete tile 9 ABS					
SCREEN OR PERFORATION OPENINGS ARE:		5 Gauzed wrapped 8 Saw cut 11 None (open hole)			
1 Continuous slot 3 Mill slot 6 Wire wrapped 9 Drilled holes					
2 Louvered shutter 4 Key punched 7 Torch cut 10 Other (specify)					
SCREEN-PERFORATED INTERVALS: From 280' ft. to 400' ft. From ft. to ft.					
GRAVEL PACK INTERVALS: From 22' ft. to 70' ft. From 80' ft. to 400' ft.					
6 GROUT MATERIAL: 1 Neat cement 2 Cement grout 3 Bentonite 4 Other					
Grout Intervals: From 0 ft. to 2 ft. From 2 ft. to 22 ft. From 70 ft. to 80 ft.					
What is the nearest source of possible contamination:		10 Livestock pens 14 Abandoned water well			
1 Septic tank 4 Lateral lines 7 Pit privy 11 Fuel storage 15 Oil well/Gas well		16 Other (specify below)			
2 Sewer lines 5 Cess pool 8 Sewage lagoon 12 Fertilizer storage					
3 Watertight sewer lines 6 Seepage pit 9 Feedyard 13 Insecticide storage					
Direction from well? Northwest		How many feet? 140'			
FROM	TO	LITHOLOGIC LOG	FROM	TO	LITHOLOGIC LOG
0	2	Surface			
2	81	Sandy Clay			
81	118	80% Med. to large sand - 20% Gravel			
118	179	90% Fine Sand - 10% Sandy Clay			
179	300	90% Med. to large sand - 10% Sandy Clay			
300	376	Med. to large sand			
376	400	95% Med. to large sand - 5% Sandy Clay			
7 CONTRACTOR'S OR LANDOWNER'S CERTIFICATION: This water well was (1) constructed (2) reconstructed, or (3) plugged under my jurisdiction and was completed on (mo/day/year) 01/26/89 and this record is true to the best of my knowledge and belief. Kansas Water Well Contractor's License No. 118 This Water Well Record was completed on (mo/day/yr) 01/27/89 under the business name of Carlile Water Well Service, Inc. by (signature)					
INSTRUCTIONS: Use typewriter or ball point pen. PLEASE PRESS FIRMLY and PRINT clearly. Please fill in blanks, underline or circle the correct answers. Send top three copies to Kansas Department of Health and Environment, Bureau of Water Protection, Topeka, Kansas 66620-7320, Telephone: 913-862-9360. Send one to WATER WELL OWNER and retain one for your records.					