

USE TYPEWRITER OR BALL POINT PEN—PRESS FIRMLY, PRINT CLEARLY.


WATER WELL RECORD
KSA 82a-1201-1215

T R EW sec 1/4 1/4 1/4 No.

Kansas State Dept. Of Health
(Water Well Contractors)
Forbes-Bldg. 740
Topeka, Kansas 66620

1 Location of well:	County Grant	Township name SW 1/4 NE 1/4	Fraction 10	Section number T 27 S	Town number R 37 W	Range number
---------------------	------------------------	---------------------------------------	-----------------------	---------------------------------	------------------------------	--------------

Distance and direction from nearest town or city: 10 North, 1/2 East, 1/4 South of Ulysses Street address of well location if in city:	3 Owner of well: Jake L. Seibert Address: R.F.D. Ulysses, Kansas 67880
---	---

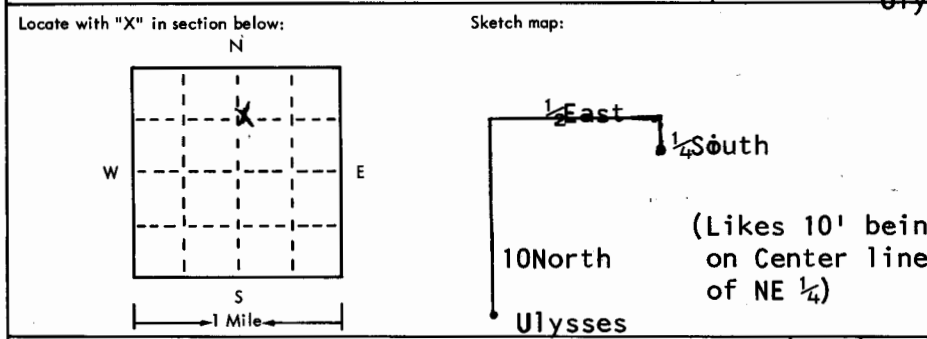

4 Well depth: **433** ft. Date of completion **7/22/75**
Well diameter **26** in.

5 Cable tool Rotary Driven Dug
 Hollow rod Jetted Bored Reverse rotary

6 Use: Domestic Public supply Industry
 Irrigation Air conditioning Commercial
 Test well

7 Casing: Material **steel** Height: above/below
Threaded Welded Surface **24** in.
Diam. **16** in. to **433** ft. depth Drive shoe? Yes No
_____ in. to _____ ft. depth

2 Type and color of material	From	To
Top Soil	0	3
Brown Sandy Clay	3	131
Fine to medium sand & gravel	131	142
Blue clay	142	159
Blue clay, gravel streak	159	182
Blue clay	182	208
Fine to Medium sand & gravel, 15% clay	218	224
Fine to medium sand & gravel	224	274
Brown sandy clay, streak of gravel	274	289
Brown sandy clay, streak of gravel sand streak	289	306
Fine sand	306	318
Brown sandy clay, brown rock	318	345
Brown sandy clay, streak of sand with brown rock (took water at 348')	345	360
Fine sand (hard)	360	365
Medium sand (tight)	365	427
Brown clay, little brown rock (use a second sheet if needed) (cont. on next sheet.)	427	438

8 Screen: Manufacturer **Johnson**
Type **Galvanized** Dia. **16"**
Slot/gauze **100x1000** Length **20'**
Set between **400** ft. and **420** ft.

*Fittings: **See remarks**
Gravel pack Yes No Size range of material **1/2 down**

9 Static water level:
195 ft. below land surface Date **7/21/75**

10 Pumping level below land surfaces:
205 ft. after **48** hrs. pumping **1400** g.p.m.
_____ ft. after _____ hrs. pumping _____ g.p.m.
Estimated maximum yield **1500** g.p.m.

11 Water sample submitted:
 Yes No Date _____

12 Well head completion:
 Pitless adapter **24** Inches above grade

13 Well grouted? Yes No
 Neat cement Bentonite _____
Depth: From **0** ft. to **10** ft.

14 Nearest source of possible contamination: **In field**
ft. _____ Direction **NONE** Type _____
Well disinfected upon completion? Yes No

15 Pump: Not installed
Manufacturer's name **Goulds**
Model number **122** HP **150** Volts _____
Length of drop pipe **400** ft. capacity **1200** g.m.p.
Type:
 Submersible Turbine
 Jet Reciprocating
 Centrifugal Other

16 Remarks: elevation

Topography:
 Hill
 Slope
 Upland
 Valley

Drilling Sub-Contracted to
**Minter Wilson Drilling; Garden City,
Kansas. License No. #208**
***Lakewood perforation-slot**

Set between **225&400&420 to 433**

17 Water well contractor's certification:
This well was drilled under my jurisdiction and this report is true to the best of my knowledge and belief.
K.I. Drilling Co., Inc. 263
Business name License No.
Address **P.O. Box 114, Ulysses, Kn.**
Signed **Bob Fischer** Date **7/28/75**
Authorized representative

