


1 LOCATION OF WATER WELL: Fraction NE 1/4 NW 1/4 NE 1/4 Section Number 11 Township Number T 27 S Range Number R 37 E/W

Distance and direction from nearest town or city street address of well if located within city?
9 miles north 1/2 east of Ulysses, Kansas

2 WATER WELL OWNER: Lewis R. Moore
RR#, St. Address, Box #: Route 1 Board of Agriculture, Division of Water Resources
City, State, ZIP Code: Ulysses, Kansas 67880 Application Number:

3 LOCATE WELL'S LOCATION WITH AN "X" IN SECTION BOX:

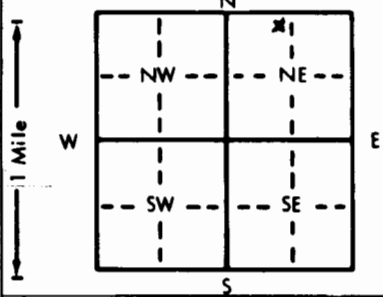

4 DEPTH OF COMPLETED WELL: 360 ft. ELEVATION: slope
Depth(s) Groundwater Encountered 1. 257 ft. 2. ft. 3. ft.
WELL'S STATIC WATER LEVEL: 257 ft. below land surface measured on mo/day/yr 7/6/1989
Pump test data: Well water was N/A after hours pumping gpm
Est. Yield gpm: Well water was N/A after hours pumping gpm
Bore Hole Diameter: 6 in. to 360 ft., and in. to ft.
WELL WATER TO BE USED AS:
5 Public water supply 8 Air conditioning 11 Injection well
1 Domestic 3 Feedlot 6 Oil field water supply 9 Dewatering 12 Other (Specify below)
2 Irrigation 4 Industrial 7 Lawn and garden only 10 Monitoring well
Was a chemical/bacteriological sample submitted to Department? Yes No X; If yes, mo/day/yr sample was submitted
Water Well Disinfected? Yes X No

5 TYPE OF BLANK CASING USED:
1 Steel 3 RMP (SR) 5 Wrought iron 8 Concrete tile CASING JOINTS: Glued X Clamped
2 PVC 4 ABS 6 Asbestos-Cement 9 Other (specify below) Welded
7 Fiberglass Threaded

Blank casing diameter: 2 in. to 320 ft., Dia. in. to ft., Dia. in. to ft.
Casing height above land surface: 24 in., weight lbs./ft. Wall thickness or gauge No. schedule 4.0

TYPE OF SCREEN OR PERFORATION MATERIAL:
1 Steel 3 Stainless steel 5 Fiberglass 7 PVC 8 RMP (SR) 10 Asbestos-cement
2 Brass 4 Galvanized steel 6 Concrete tile 9 ABS 11 Other (specify)
12 None used (open hole)

SCREEN OR PERFORATION OPENINGS ARE:
1 Continuous slot 3 Mill slot 5 Gauzed wrapped 8 Saw cut 11 None (open hole)
2 Louvered shutter 4 Key punched 6 Wire wrapped 9 Drilled holes
7 Torch cut 10 Other (specify)

SCREEN-PERFORATED INTERVALS: From 320 ft. to 360 ft., From ft. to ft.
GRAVEL PACK INTERVALS: From 10 ft. to 360 ft., From ft. to ft.

6 GROUT MATERIAL: 1 Neat cement 2 Cement grout 3 Bentonite 4 Other
Grout Intervals: From 0 to 10 ft., From ft. to ft., From ft. to ft.

What is the nearest source of possible contamination:
1 Septic tank 4 Lateral lines 7 Pit privy 10 Livestock pens 14 Abandoned water well
2 Sewer lines 5 Cess pool 8 Sewage lagoon 11 Fuel storage 15 Oil well/Gas well
3 Watertight sewer lines 6 Seepage pit 9 Feedyard 12 Fertilizer storage 16 Other (specify below)
13 Insecticide storage

Direction from well? north How many feet? 310

FROM	TO	LITHOLOGIC LOG	FROM	TO	PLUGGING INTERVALS
0	2	Surface			
2	120	Brown ex clay			
120	152	Blue and gray clay			
152	225	Brown and gray clay w/small strips of fine sand			
225	245	Sandy clay			
245	255	Medium to coarse sand			
255	261	Sandy clay			
261	283	Medium to coarse sand			
283	315	Sandy clay w/lime shells & fine sand			
315	333	Sandy clay w/tight clay strips			
333	347	Fine sand w/strips of sandy clay			
347	355	Brown and yellow yellow chalk w/sandstone			
355	373	Sandstone			

7 CONTRACTOR'S OR LANDOWNER'S CERTIFICATION: This water well was (1) constructed, (2) reconstructed, or (3) plugged under my jurisdiction and was completed on (mo/day/year) July 6, 1989 and this record is true to the best of my knowledge and belief. Kansas Water Well Contractor's License No. 164 This Water Well Record was completed on (mo/day/yr) June 19, 1990 under the business name of Houck Bros. Drlg. Co. by (signature) M. Beard