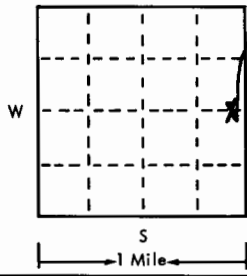
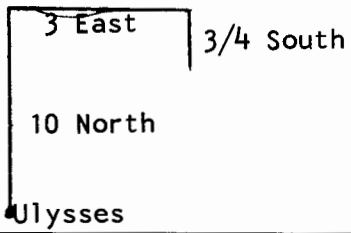


USE TYPEWRITER OR BALL POINT PEN—PRESS FIRMLY, PRINT CLEARLY.

WATER WELL RECORD
KSA 82a-1201-1215

T R EW sec 1/4 1/4 1/4 No.

Kansas State Dept. Of Health
(Water Well Contractors)
Forbes-Bldg. 740
Topeka, Kansas 66620

1 Location of well:	County Grant	Township name	Fraction NE¹/₄, NE¹/₄, SE¹/₄	Section number 12	Town number T275	Range number R37W
Distance and direction from nearest town or city: 10 North, 3 East, 3/4 South of Ulysses Street address of well location if in city:			3 Owner of well: Leslie Walker Address: 600 Juniper Street Truth or Conseques, New Mexico 87901			
Locate with "X" in section below: N 		Sketch map: 		4 Well depth: 465 ft. Date of completion 6-16-75 Well diameter 26 in.		
2 Type and color of material		From To		5 <input type="checkbox"/> Cable tool <input type="checkbox"/> Rotary <input type="checkbox"/> Driven <input type="checkbox"/> Dug <input type="checkbox"/> Hollow rod <input type="checkbox"/> Jetted <input type="checkbox"/> Bored <input checked="" type="checkbox"/> Reverse rotary		
				6 Use: <input type="checkbox"/> Domestic <input type="checkbox"/> Public supply <input type="checkbox"/> Industry <input checked="" type="checkbox"/> Irrigation <input type="checkbox"/> Air conditioning <input type="checkbox"/> Commercial <input type="checkbox"/> Test well <input type="checkbox"/>		
Surface and Brown Sandy Clay		0 15		7 Casing: Material Steel Height: above/below Threaded <input type="checkbox"/> Welded <input checked="" type="checkbox"/> Surface 12 in. Diam. Weight 34.25 lbs./ft. 16 in. to 465 ft. depth Drive shoe? <input type="checkbox"/> Yes <input checked="" type="checkbox"/> No		
Brown Sandy Clay		15 45		8 Screen: Manufacturer Johnson Type Galvanized Dia. 16" Slot/gauze 100x100 Length 30' Set between 317 ft. and 327 ft. 407-427 * Fittings: See Remarks Gravel pack <input checked="" type="checkbox"/> Yes <input type="checkbox"/> No Size range of material 1/2 down		
Brown Clay		45 120		9 Static water level: 195 ft. below land surface Date 4/29/75		
Coarse Sand		260 285		10 Pumping level below land surfaces: 245 ft. after 12 hrs. pumping 800 g.p.m. ____ ft. after ____ hrs. pumping ____ g.p.m. Estimated maximum yield 1000 g.p.m.		
Brown Clay		285 320		11 Water sample submitted: <input type="checkbox"/> Yes <input checked="" type="checkbox"/> No Date _____		
Coarse Sand		320 345		12 Well head completion: <input type="checkbox"/> Pitless adapter 12 Inches above grade		
Brown Sandy Clay-Sand-25%		345 375		13 Well grouted? <input checked="" type="checkbox"/> Yes <input type="checkbox"/> No <input checked="" type="checkbox"/> Neat cement <input checked="" type="checkbox"/> Bentonite <input type="checkbox"/> _____ Depth: From 0 ft. to 10 ft.		
Blue Shale mixed with Dakota		375 455		14 Nearest source of possible contamination: in field ft. _____ Direction NONE Type _____ Well disinfected upon completion? <input type="checkbox"/> Yes <input checked="" type="checkbox"/> No		
Red and Brown Sandstone		455 465		15 Pump: <input type="checkbox"/> Not installed Manufacturer's name Goulds(used) Model number used HP 100 Volts _____ Length of drop pipe 360 ft. capacity 1000 g.p.m. Type: <input type="checkbox"/> Submersible <input checked="" type="checkbox"/> Turbine <input type="checkbox"/> Jet <input type="checkbox"/> Reciprocating <input type="checkbox"/> Centrifugal <input type="checkbox"/> Other		
Blue and Brown Shale		465 495		17 Water well contractor's certification: This well was drilled under my jurisdiction and this report is true to the best of my knowledge and belief. K.I. Drilling # 263 Business name License No. Address Ulysses, Kansas 67880 Signed Bob Stuber date 6/4/75 Authorized representative		
16 Remarks: elevation K.I. Drilling Sub-Contracted by License No. #208 Minter Wilson Drilling Garden City, Kansas Topography: <input type="checkbox"/> Hill <input checked="" type="checkbox"/> Slope * Lakewood Perf- Slot- .125x66 <input type="checkbox"/> Upland Set between 327 & 407' & 427' to 465' <input type="checkbox"/> Valley						