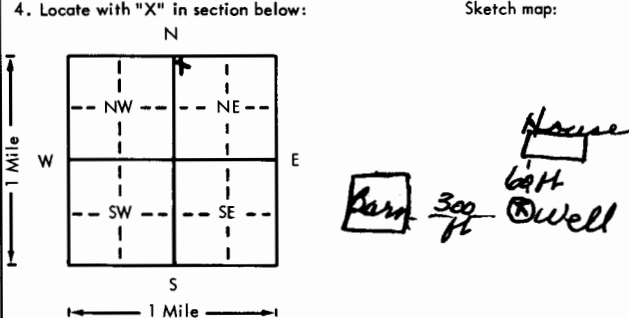


USE TYPEWRITER OR BALL POINT PEN-PRESS FIRMLY, PRINT CLEARLY.

WATER WELL RECORD
KSA 82a-1201-1215

Kansas Department of Health and Environment-Division of Environment
(Water well Contractors)
Topeka, Kansas 66620

1. Location of well:	County Grant	Fraction NW 1/4 NW 1/4 NE 1/4	Section number 23	Township number T 27 S R	Range number 37 EW
2. Distance and direction from nearest town or city: 7 north, 8 east. 1 north of the four way stop at Ulysses Street address of well location if in city: 1/2 back west		3. Owner of well: John Crump R.F.D. 1 City, state, zip code: Ulysses, Ks. 67880			
4. Locate with "X" in section below: Sketch map: 			6. Bore hole dia. 9 1/4 in. Completion date 12-29-78 Well depth 400 ft.		
5. Type and color of material			7. <input checked="" type="checkbox"/> Cable tool <input checked="" type="checkbox"/> Rotary <input type="checkbox"/> Driven <input type="checkbox"/> Dug <input type="checkbox"/> Hollow rod <input type="checkbox"/> Jetted <input type="checkbox"/> Bored <input type="checkbox"/> Reverse rotary		
Surface			8. Use: <input checked="" type="checkbox"/> Domestic <input type="checkbox"/> Public supply <input type="checkbox"/> Industry <input type="checkbox"/> Irrigation <input type="checkbox"/> Air conditioning <input type="checkbox"/> Stock <input type="checkbox"/> Lawn <input type="checkbox"/> Oil field water <input type="checkbox"/> Other		
Clay, Fine sand and lime shells			9. Casing: Material styrene <input checked="" type="checkbox"/> Above <input type="checkbox"/> below glued and rivet Surface 18 in. RMP _____ PVC _____ Weight _____ lbs./ft. Dia. 5 in. to 340 ft. depth Wall Thickness: inches or Dia. _____ in. to _____ ft. depth gage No. 320		
Sandy clay			10. Screen: Manufacturer's name _____ Sunflower Type Styrene Dia. 5" Slot/gauze 1/16" Length 60' Set between 340 ft. and 400 ft. _____ ft. and _____ ft. Gravel pack? <input checked="" type="checkbox"/> Size range of material 1/4"		
Gummy clay			11. Static water level: _____ mo./day/yr. 285 ft. below land surface Date 9/19/78		
Sandy clayw/sandstone strips			12. Pumping level below land surfaces: 305 ft. after 70 hrs. pumping 15 g.p.m. _____ ft. after _____ hrs. pumping _____ g.p.m. Estimated maximum yield 25 g.p.m.		
Fine to medium sand			13. Water sample submitted: _____ mo./day/yr. Yes <input checked="" type="checkbox"/> No <input type="checkbox"/> Date _____		
Sandy clay w/fine sand			14. Well head completion: <input checked="" type="checkbox"/> Pitless adapter 18 Inches above grade		
Yellow chalk			15. Well grouted? <input checked="" type="checkbox"/> With: <input checked="" type="checkbox"/> Neat cement <input type="checkbox"/> Bentonite <input type="checkbox"/> Concrete Depth: From 0 ft. to 10 ft.		
Yellow chalk and Dakota sandstone			16. Nearest source of possible contamination: ft. 250 Direction EAST Type Septic Well disinfected upon completion? <input checked="" type="checkbox"/> Yes <input type="checkbox"/> No		
Brown shale w/sandstone strips			17. Pump: <input checked="" type="checkbox"/> Not installed Manufacturer's name _____ Model number _____ HP _____ Volts _____ Length of drop pipe _____ ft. capacity _____ g.p.m. Type: <input type="checkbox"/> Submersible <input type="checkbox"/> Turbine <input type="checkbox"/> Jet <input type="checkbox"/> Reciprocating <input type="checkbox"/> Centrifugal <input type="checkbox"/> Other		
(Use a second sheet if needed)					
18. Elevation:		19. Remarks:		20. Water well contractor's certification: This well was drilled under my jurisdiction and this report is true to the best of my knowledge and belief. Houck Bros. Drlg. Co. 164 Business name Box 487, Ulysses, Ks. License No. _____ Address _____ Signed Melvin M. Beard Date 6/29/78 Authorized representative	
Topography: <input type="checkbox"/> Hill <input checked="" type="checkbox"/> Slope <input type="checkbox"/> Upland <input type="checkbox"/> Valley					

27 370 23
 T
 R
 Sec
 1/4 1/4 1/4