

USE TYPEWRITER OR BALL POINT PEN-PRESS FIRMLY, PRINT CLEARLY.

WATER WELL RECORD  
KSA 82a-1201-1215


T R EW sec 1/4 1/4 1/4 No.

Kansas State Dept. Of Health  
(Water Well Contractors)  
Forbes-Bldg. 740  
Topeka, Kansas 66620

1 Location of well:	County <b>Grant</b>	Township name	Fraction <b>C-NW 1/4</b>	Section number <b>28</b>	Town number <b>T27S</b>	Range number <b>R37W</b>
---------------------	------------------------	---------------	-----------------------------	-----------------------------	----------------------------	-----------------------------

Distance and direction from nearest town or city:  
**6 Mi. N., 1 West, 1/2 S., & 1/4 East of**  
Street address of well location if in city: **Ulysses, Kansas**

3 Owner of well: **Keith Pucket**  
Address: **Route 3 Ulysses, Kansas 67880**

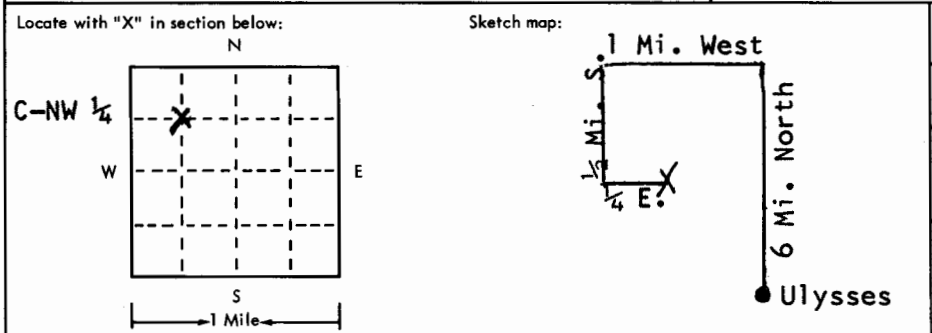

4 Well depth: 590 ft. Date of completion 2-13-75  
Well diameter 26 in.

5  Cable tool  Rotary  Driven  Dug  
 Hollow rod  Jetted  Bored  Reverse rotary

6 Use:  Domestic  Public supply  Industry  
 Irrigation  Air conditioning  Commercial  
 Test well

7 Casing: Material Steel Height: above/~~land~~  
Threaded  Welded  Surface 24 in.  
Diam. 16 in. Weight 34 1/2 lbs./ft.  
16 in. to 590 ft. depth Drive shoe?  Yes  No  
\_\_\_ in. to \_\_\_ ft. depth

2	Type and color of material	From	To
	Surface & sticky Brown Clay	0	200
	Sand, Gravel & Clay Streaks (loose)	200	274
	Brown Clay	274	280
	Sandstone & Blue Shale (coarse streaks)	280	340
	Sandstone, Shale & Rock Streaks (coarse streaks)	340	360
	" " " " (Hard)	360	380
	Blue Shale & Rock (Hard)	380	440
	Sandstone, Blue Shale & Rock (Loose Streaks)	440	580
	Sandstone & Shale	580	590
	Red Bed	590	600
	Very bad water loss from 290' to 600'		
	(use a second sheet if needed)		

8 Screen:  
Manufacturer Johnson  
Type Galvanized Dia. 16"  
Slot/gauze 100x100 Length 20ft.  
Set between 500 ft. and 520 ft.  
\*Fittings: See Remarks  
Gravel pack  Yes  No Size range of material 1/2" down

9 Static water level:  
205 ft. below land surface Date 3-13-75

10 Pumping level below land surfaces:  
320 ft. after 24 hrs. pumping 1400 g.p.m.  
\_\_\_ ft. after \_\_\_ hrs. pumping \_\_\_ g.p.m.  
Estimated maximum yield 1400 g.p.m.

11 Water sample submitted:  
 Yes  No Date \_\_\_\_\_

12 Well head completion:  
 Pitless adapter 24 inches above grade

13 Well grouted?  Yes  No  
 Neat cement  Bentonite  \_\_\_\_\_  
Depth: From 0 ft. to 10 ft.

14 Nearest source of possible contamination: in field  
ft. \_\_\_\_\_ Direction none Type \_\_\_\_\_  
Well disinfected upon completion?  Yes  No

15 Pump:  Not installed  
Manufacturer's name Peerless  
Model number Used HP 150 Volts \_\_\_\_\_  
Length of drop pipe 340 ft. capacity 1400 g.p.m.  
Type:  
 Submersible  Turbine  
 Jet  Reciprocating  
 Centrifugal  Other

16 Remarks: elevation  
Topography:  
 Hill  
 Slope  
 Upland  
 Valley

Drilling Sub-contracted to:  
**Minter-Wilson Drilling Co., License #208**  
**Garden City, Kansas 67846**  
**\*Lakewood Perf. Slot .125 X 66**  
**Set between 220' to 500' & from**  
**520' to 590'**

17 Water well contractor's certification:  
This well was drilled under my jurisdiction and this report is true to the best of my knowledge and belief.  
K. I. Drilling Co. 263  
Business name License No.  
Address Box 669, Ulysses, Kan.  
Signed Keith Pucket Date 2-20-75  
Authorized representative