

WATER WELL RECORD

Form WWC-5


Division of Water Resources App. No.

23165

1 LOCATION OF WATER WELL: County: GRANT Fraction 1/4 NW 1/4 NW 1/4 SE 1/4 Section Number 13 Township No. T 27 S Range Number R 37 E W

Street/Rural Address of Well Location; if unknown, distance & direction from nearest town or intersection: NORTH SIDE OF ULYSSES, 6 MILES NORTH, 3 MILES EAST, 1 MILE NORTH 2485'N 2590'W

2 WATER WELL OWNER: EUGENE SPENCER RR#, Street Address, Box #: 1151 ROAD 30 City, State, ZIP Code : ULYSSES, KS. 67880

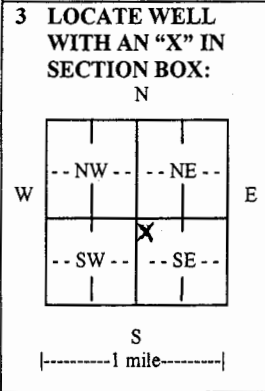

4 DEPTH OF COMPLETED WELL 420 ft. Depth(s) Groundwater Encountered (1)..... ft. (2)..... ft. (3)..... ft. WELL'S STATIC WATER LEVEL 250 ft. below land surface measured on mo/day/yr. 6-15-10 Pump test data: Well water was.....ft. after..... hours pumping..... gpm EST. YIELD.....gpm. Well water was.....ft. after..... hours pumping..... gpm Bore Hole Diameter 30.....in. to 420.....ft., and.....in. to.....ft. WELL WATER TO BE USED AS: [] Public water supply [] Geothermal [] Injection well [] Domestic [] Feedlot [] Oil field water supply [] Dewatering [] Other (Specify below) [x] Irrigation [] Industrial [] Domestic-lawn & garden [] Monitoring well Was a chemical/bacteriological sample submitted to Department? [] Yes [x] No If yes, mo/day/yr sample was submitted..... Water well disinfected? [] Yes [x] No

5 TYPE OF CASING USED: [x] Steel [] PVC [] Other CASING JOINTS: [] Glued [] Clamped [x] Welded [] Threaded Casing diameter .16..... in. to .295..... ft., Diameter..... in. to..... ft., Diameter..... in. to..... ft. Casing height above land surface.....12..... in., Weight 42.05.....lbs./ft., Wall thickness or gauge No.250 TYPE OF SCREEN OR PERFORATION MATERIAL: [x] Steel [] Stainless Steel [] PVC [] Other (Specify) [] Brass [] Galvanized Steel [] None used (open hole) SCREEN OR PERFORATION OPENINGS ARE: [] Continuous slot [x] Mill slot [] Gauze wrapped [] Torch cut [] Drilled holes [] None (open hole) [] Louvered shutter [] Key punched [x] Wire wrapped [] Saw cut [] Other (specify) SCREEN-PERFORATED INTERVALS: From.....295..... ft. to420..... ft., From..... ft. to..... ft. GRAVEL PACK INTERVALS: From.....20..... ft. to420..... ft., From..... ft. to..... ft. From..... ft. to..... ft., From..... ft. to..... ft.

6 GROUT MATERIAL: [] Neat cement [x] Cement grout [] Bentonite [] Other Grout Intervals: From 0..... ft. to 20..... ft., From..... ft. to..... ft., From..... ft. to..... ft. What is the nearest source of possible contamination: [] Septic tank [] Lateral lines [] Pit privy [] Livestock pens [] Insecticide storage [] Other (specify below) [] Sewer lines [] Cesspool [] Sewage lagoon [] Fuel storage [x] Abandoned water well [] Watertight sewer lines [] Seepage pit [] Feedyard [] Fertilizer storage [] Oil well/gas well Direction from well NORTHWEST Distance from well .90' NORTH .20' WEST

Table with columns: FROM, TO, LITHOLOGIC LOG, FROM, TO, LITHO. LOG (cont.) or PLUGGING INTERVALS. Contains text 'SEE ATTACHED LOG'.

7 CONTRACTOR'S OR LANDOWNER'S CERTIFICATION: This water well was [x] constructed, [] reconstructed, or [] plugged under my jurisdiction and was completed on (mo/day/year) 6-15-10..... and this record is true to the best of my knowledge and belief. Kansas Water Well Contractor's License No. 208..... This Water Well Record was completed on (mo/day/year) 6-22-10..... under the business name of MINTER WILSON DRILLING CO. INC. by (signature) Paula Barker

INSTRUCTIONS: Use typewriter or ball point pen. PLEASE PRESS FIRMLY and PRINT clearly. Please fill in blanks and check the correct answers. Send three copies (white, blue, pink) to Kansas Department of Health and Environment, Bureau of Water, Geology Section, 1000 SW Jackson St., Suite 420, Topeka, Kansas 66612-1367. Telephone 785-296-5522. Send one copy to WATER WELL OWNER and retain one for your records. Include fee of \$5.00 for each constructed well. Visit us at http://www.kdheks.gov/waterwell/index.html

*The
Professionals*

MINTER-WILSON DRILLING CO.

INCORPORATED

Irrigation
and Domestic
Water Systems
Complete Installation
and Repairing

Phone 620-276-8269 • P.O. Box A • GARDEN CITY, KANSAS 67846

NAME GENE SPENCER
COUNTY GRANT
DATE 5-28-10

LOCATION: SE 1/4 13-27-37 - FROM HITCH ROAD & M ROAD - 1 MILE NORTH,
1/2 MILE WEST & 1/2 MILE NORTH
- ABOUT 90 FT SOUTH OF EXISTING WELL

STATIC WATER LEVEL - APPROX. 250 FT.

TEST # 5

0' TO 20' - BROWN SANDY CLAY
20' TO 53' - BROWN & WHITE SANDY CLAY
WITH STRIPS OF WHITE ROCK
53' TO 80' - BROWN CLAY
80' TO 100' - GRAY CLAY - STICKY
100' TO 110' - BROWN CLAY WITH STRIPS OF SAND & GRAVEL
110' TO 120' - GRAY & BROWN CLAY
120' TO 190' - BLUE CLAY
190' TO 225' - BROWN SANDY CLAY, BROWN CLAY & BLUE CLAY LAYERED
225' TO 246' - FINE TO MEDIUM SAND & GRAVEL
WITH STRIPS OF BROWN SANDY CLAY
246' TO 251' - BROWN SANDY CLAY
251' TO 282' - FINE TO MEDIUM SAND & GRAVEL
WITH STRIPS OF BROWN SANDY CLAY
282' TO 295' - BROWN SANDY CLAY
WITH STRIPS OF WHITE ROCK
295' TO 305' - FINE SAND & SAND STONE
WITH STRIPS OF BROWN CLAY 15%
305' TO 329' - SANDY BROWN & WHITE CLAY - SOME BLUE
WITH 25% SAND STONE
329' TO 338' - FINE SAND STONE WITH SOME SHALE 20%
- 250 PULL DOWN
338' TO 340' - HARD YELLOW SAND STONE - 300 PULL DOWN
340' TO 346' - SHALE
346' TO 350' - SAND STONE - LOOSE
350' TO 368' - SHALE WITH STRIPS OF SANDY YELLOW CLAY
& SAND STONE - 20%
368' TO 371' - SAND STONE
371' TO 381' - SHALE WITH STRIPS OF SAND STONE 30%
381' TO 386' - SAND STONE
386' TO 390' - SHALE, WHITE & YELLOW CLAY WITH 50% SAND STONE
389' TO 399' - SHALE WITH STRIPS OF SAND STONE 30%
399' TO 401' - SAND STONE - LOOSE
401' TO 405' - SHALE WITH STRIPS OF SAND STONE 30%
405' TO 419' - SHALE WITH 10% SAND STONE
419' TO 522' - SHALE - 300 PULL DOWN
522' TO 575' - SAND STONE - LOOSE
WITH LAYERS OF BROWN & YELLOW CLAY 30%