


Street/Rural Address of Well Location; if unknown, distance & direction from nearest town or intersection: If at owner's address, check here Hwy 25 & Rd 1

Global Positioning System (GPS) information:
 Latitude: 37.7293 (in decimal degrees)
 Longitude: 101.3732 (in decimal degrees)
 Elevation: _____
 Datum: WGS 84, NAD 83, NAD 27

2 WATER WELL OWNER: J.L. Seibert
 RR#, Street Address, Box #: 1037 E Rd 5
 City, State, ZIP Code : Ulysses, KS 67880

Collection Method:
 GPS unit (Make/Model: Garmin _____)
 Digital Map/Photo, Topographic Map, Land Survey
 Est. Accuracy: <3 m, 3-5 m, 5-15 m, >15 m

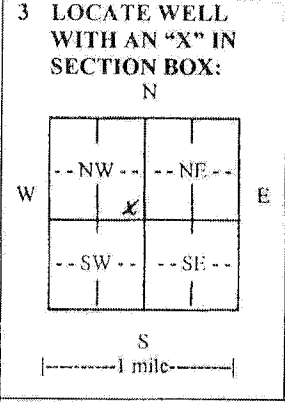

4 DEPTH OF COMPLETED WELL 700 ft.
 Depth(s) Groundwater Encountered (1) _____ ft. (2) _____ ft. (3) _____ ft.
 WELL'S STATIC WATER LEVEL _____ ft. below land surface measured on mo/day/yr. _____
 Pump test data: Well water was _____ ft. after _____ hours pumping _____ gpm
 EST. YIELD _____ gpm. Well water was _____ ft. after _____ hours pumping _____ gpm
 Bore Hole Diameter 26 in. to _____ ft., and _____ in. to _____ ft.
 WELL WATER TO BE USED AS: Public water supply Geothermal Injection well
 Domestic Feedlot Oil field water supply Dewatering Other (Specify below)
 Irrigation Industrial Domestic-lawn & garden Monitoring well _____
 Was a chemical/bacteriological sample submitted to Department? Yes No
 If yes, mo/day/yr sample was submitted _____
 Water well disinfected? Yes No

5 TYPE OF CASING USED: Steel PVC Other _____
 CASING JOINTS: Glued Clamped Welded Threaded
 Casing diameter 16 in. to 700 ft., Diameter _____ in. to _____ ft., Diameter _____ in. to _____ ft.
 Casing height above land surface 12 in., Weight _____ lbs./ft., Wall thickness or gauge No. 0.25
 TYPE OF SCREEN OR PERFORATION MATERIAL:
 Steel Stainless Steel PVC Other (Specify) _____
 Brass Galvanized Steel None used (open hole)
 SCREEN OR PERFORATION OPENINGS ARE:
 Continuous slot Mill slot Gauze wrapped Torch cut Drilled holes None (open hole)
 Louvered shutter Key punched Wire wrapped Saw cut Other (specify) _____
 SCREEN-PERFORATED INTERVALS: From 380 ft. to 400 ft., From 440 ft. to 460 ft.
 From 500 ft. to 580 ft., From 620-640 ft. to 680-700 ft.
 GRAVEL PACK INTERVALS: From 20 ft. to 700 ft., From _____ ft. to _____ ft.

6 GROUT MATERIAL: Neat cement Cement grout Bentonite Other _____
 Grout Intervals: From 0 ft. to 20 ft., From _____ ft. to _____ ft., From _____ ft. to _____ ft.
 What is the nearest source of possible contamination:
 Septic tank Lateral lines Pit privy Livestock pens Insecticide storage Other (specify below)
 Sewer lines Cesspool Sewage lagoon Fuel storage Abandoned water well
 Watertight sewer lines Seepage pit Feedyard Fertilizer storage Oil well/gas well _____
 Direction from well South Distance from well 150

FROM	TO	LITHOLOGIC LOG	FROM	TO	LITHO. LOG (cont.) or PLUGGING INTERVALS
		See Attached			

7 CONTRACTOR'S OR LANDOWNER'S CERTIFICATION: This water well was constructed, reconstructed, or plugged under my jurisdiction and was completed on (mo/day/year) 12-28-11 and this record is true to the best of my knowledge and belief. Kansas Water Well Contractor's License No. 473 This Water Well Record was completed on (mo/day/year) 1-12-12 under the business name of Tyler Water Well Inc by (signature) _____

INSTRUCTIONS: Use typewriter or ball point pen. PLEASE PRESS FIRMLY and PRINT clearly. Please fill in blanks and check the correct answers. Send three copies (white, blue, pink) to Kansas Department of Health and Environment, Bureau of Water, Geology Section, 1000 SW Jackson St., Suite 420, Topeka, Kansas 66612-1367. Telephone 785-296-5524. Send one copy to WATER WELL OWNER and retain one for your records. Include fee of \$5.00 for each constructed well. Visit us at <http://www.kdheks.gov/waterwell/index.html>.

Tyler Water Well Service Inc.
 5730 N 3rd St Garden City Ks 67846

1-800-540-0793

T.H.#: 1

Contract Name: J.L. Siebert

City/State: Ulysses Ks

Test Hole Location: 11N&.5W of Ulysses, NW/NW/NE 4-27-37

Driller: Destal Tyler

Approx Static Water Level Measured: 260?

From	To	Formation	Fair	Good
0	5	BROWN CLAY & A LITTLE CALICHE		
5	15	FINE SANDY CLAY		
15	82	BROWN CLAY & A LITTLE CALICHE		
82	114	SANDY CLAY		
114	203	BROWN & GRAY STICKY CLAY		
203	229	MED SAND & ALITTLE CLAY		
229	246	CEMENTED SAND & CLAY		
246	262	CALICHE , CLAY & SAND	16	
262	286	FINE SAND & A LITTLE CLAY		
286	295	BLUE CLAY	29	
295	324	FINE SAND & A LITTLE CLAY		
324	328	BROWN CLAY	86	
328	414	FINE SANDSTONE & A LITTLE BROWN, GRAY & RED CLAY		
414	418	IRON PYRITE		
418	530	BROWN & GRAY CLAY	5	
530	535	SANDSTONE		
535	555	GRAY CLAY		
555	560	IRON PYRITE		
560	580	GRAY CLAY		
580	595	SANDSTONE & GRAY CLAY		
595	606	GRAY CLAY	49	
606	655	SANDSTONE & A LITTLE CLAY		
655	665	GRAY CLAY	35	
665	700	SANDSTONE & A LITTLE CLAY		
700	705	RED BED		

356-5720